

RECEIVED


JUL 12 1996

UNITED STATES RESOURCES DEPT.
DEPARTMENT OF THE INTERIOR
GEOLOGICAL SURVEY

RECEIVED

JAN - 4 1995
WATER RESOURCES DEPT
SALEM OREGON

270 N SE
(STINKING LAKE)

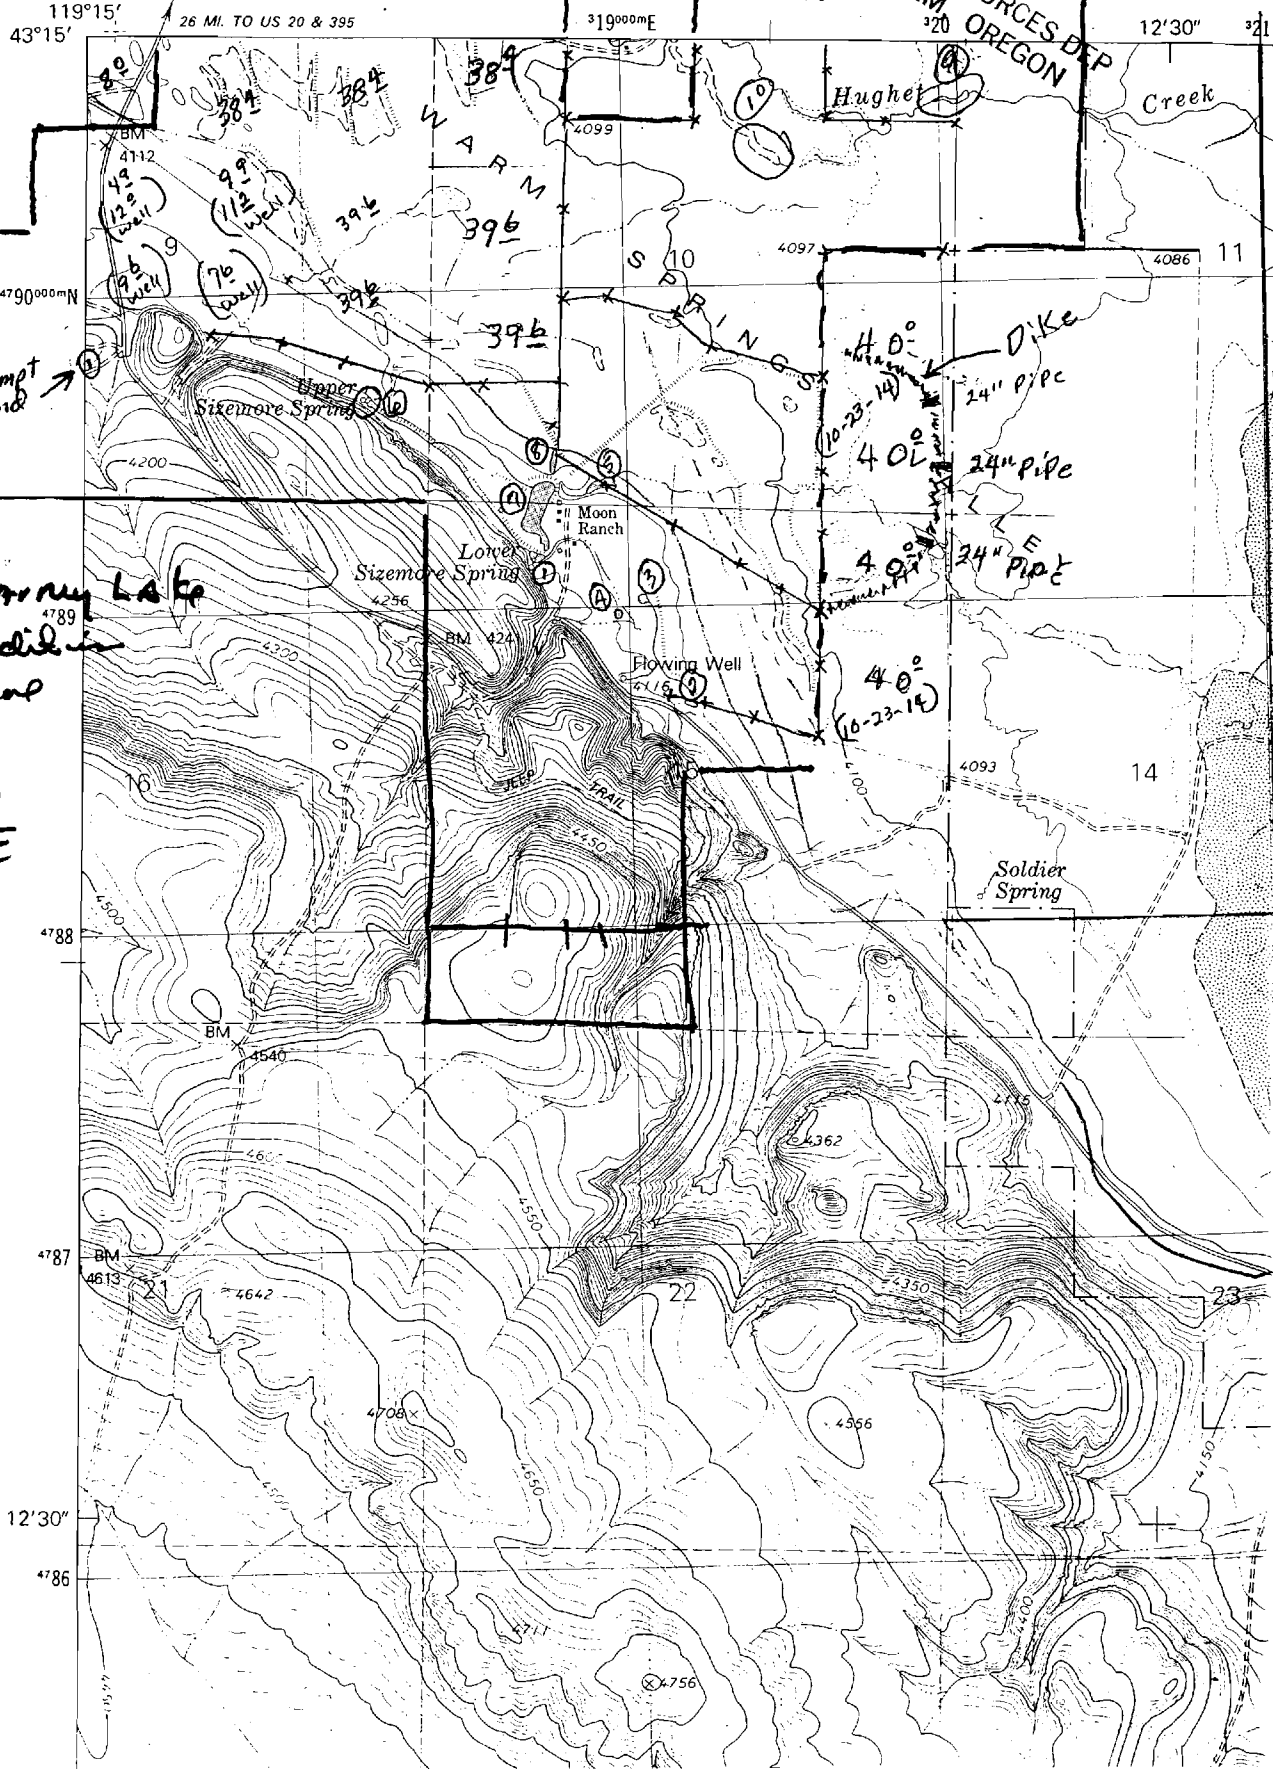

Southwest Horny Lake
1980 Edition
W.H. Benz

T-27-S
R-29-E

Application No. 83347
Permit No. 80723
Cent