


7, 8, 10, 11, 12, 13
4, 15, 16, 18, 19
30, 31, 34, 35, 36
RECEIVED
DEC 30 1994
WATER RESOURCES DEPT.
SALEM, OREGON

3527E

SEC 19
PLANT 1000

SEC 5 31 9 12
PLANT 1000


511 MAP 35 26

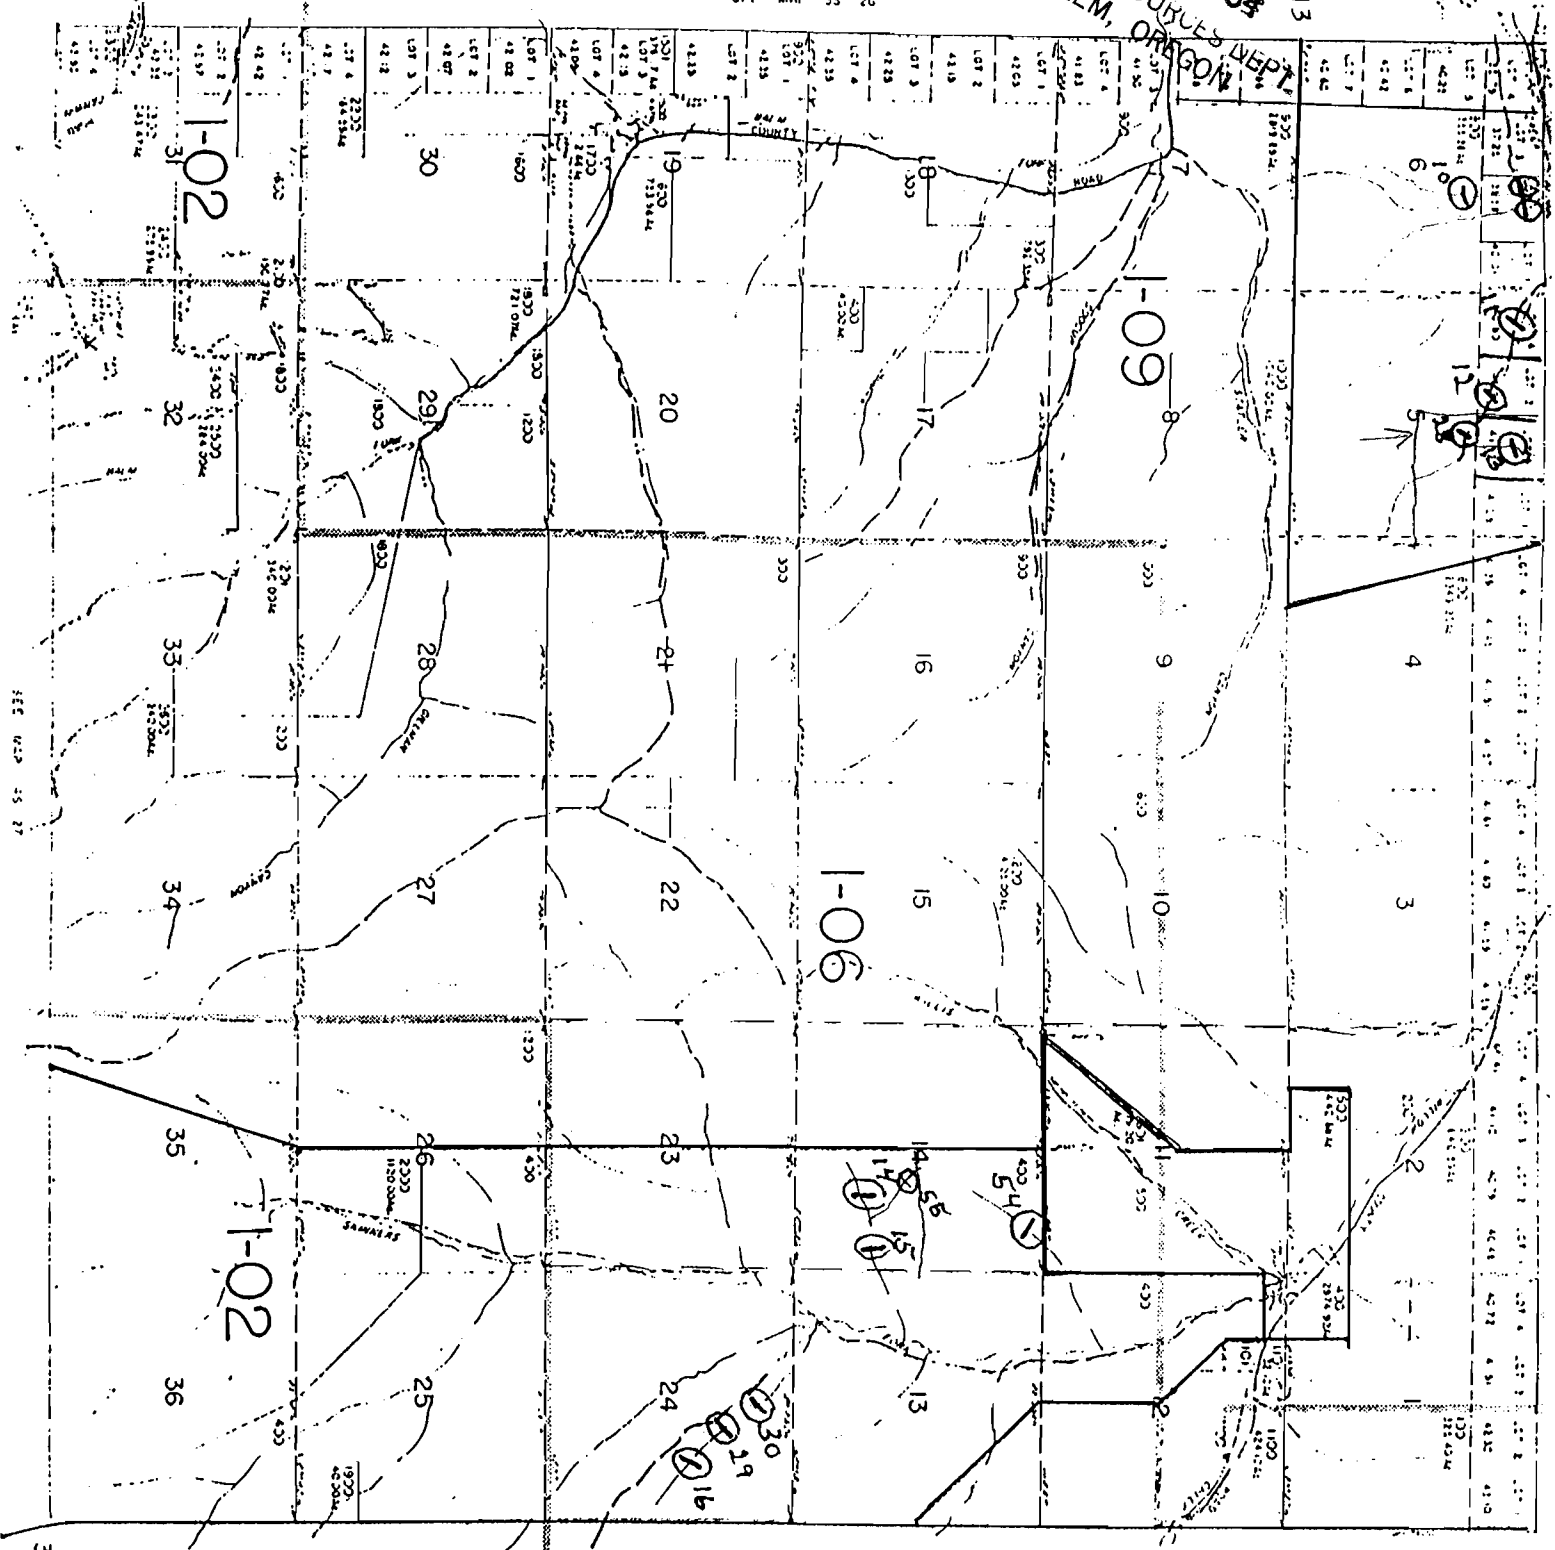

511 MAP 35 26

35 27

3528E

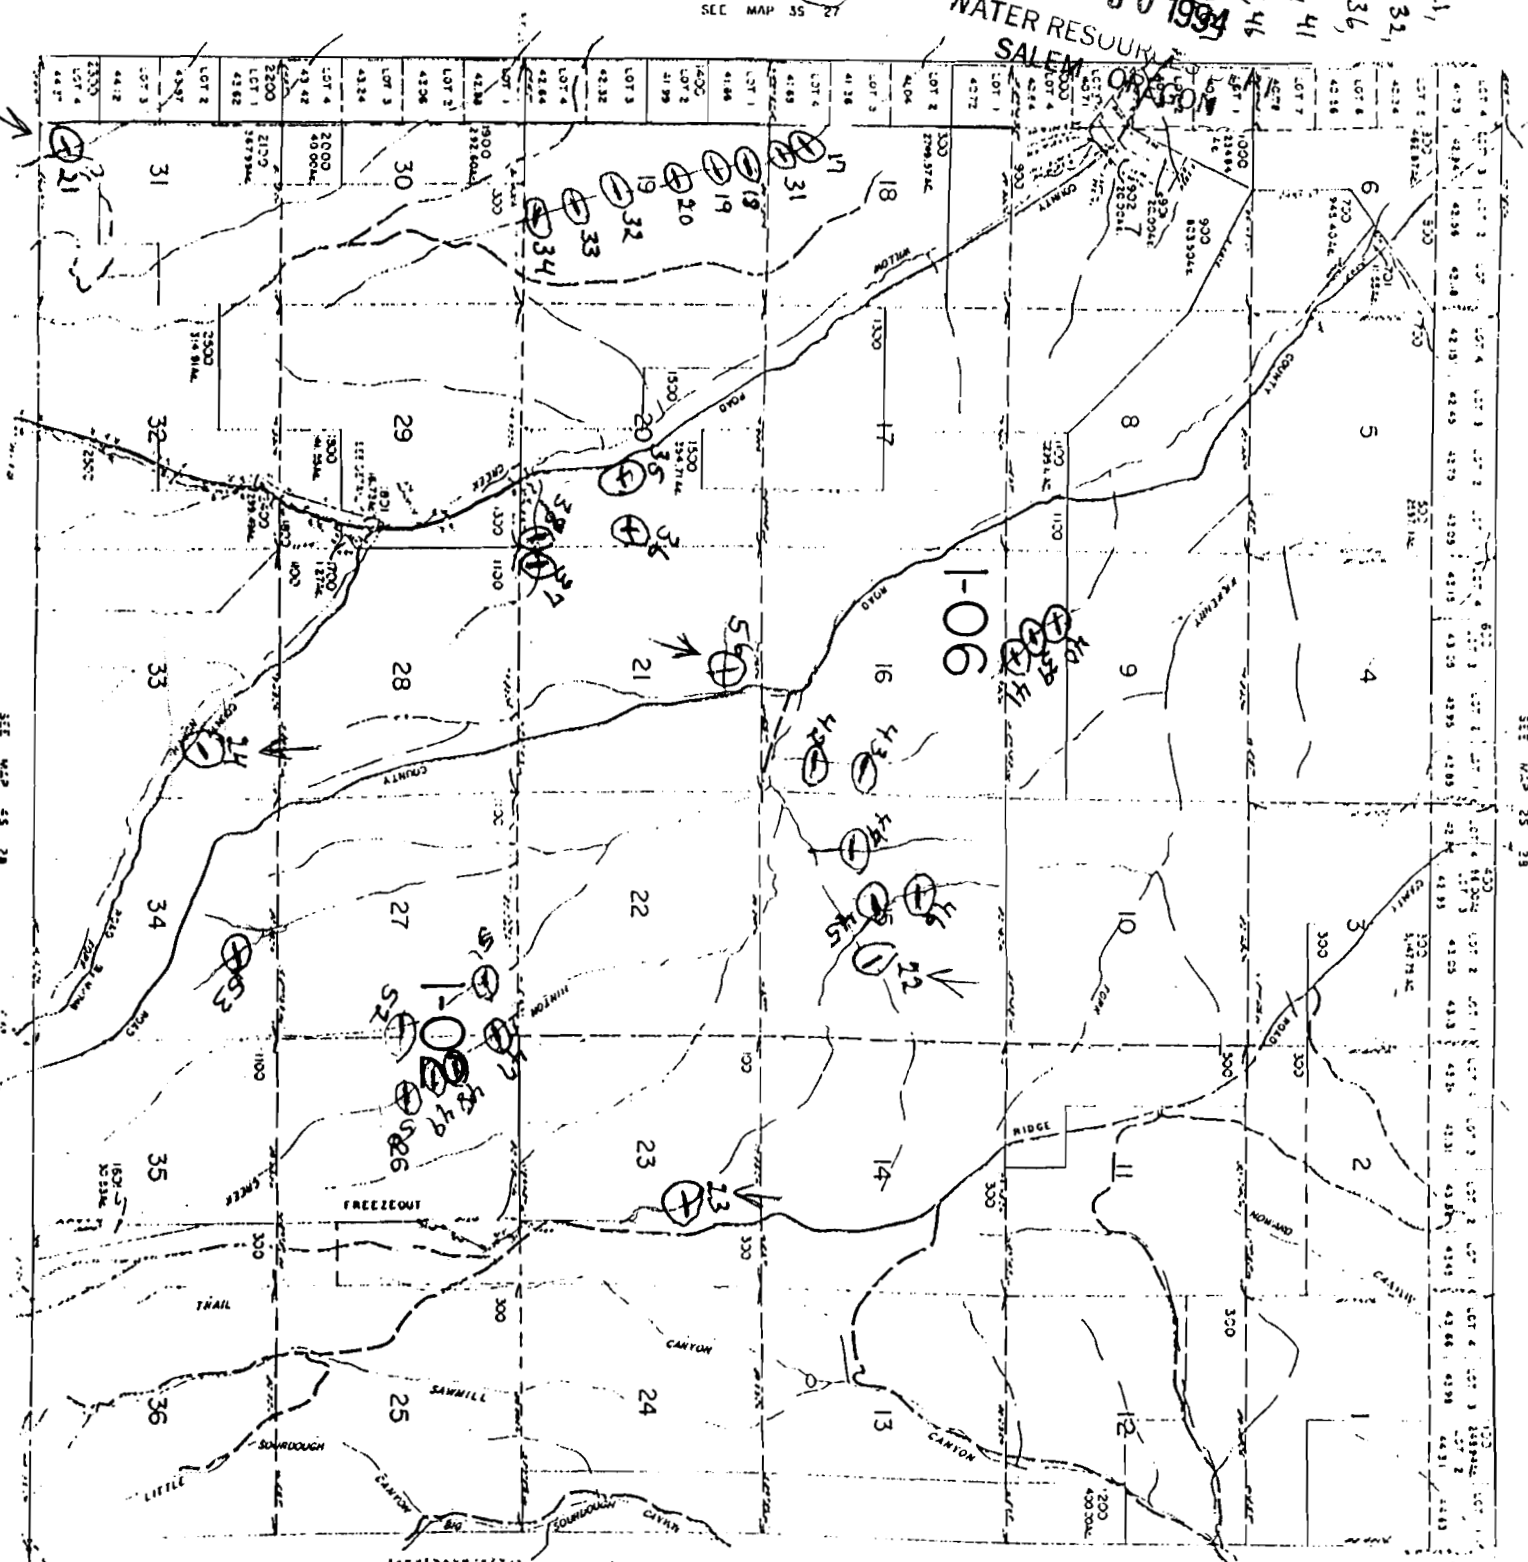

Application No. R-81582
Permit No.

Order #:
25, 26, 27

RECEIVED

DEC 30 1994
WATER RESOURCES
SALEM, OREGON

4528 E

SEE MAP 27

SEE MAP 45 29

