


T. 9 S., R. 3 E., W.M.

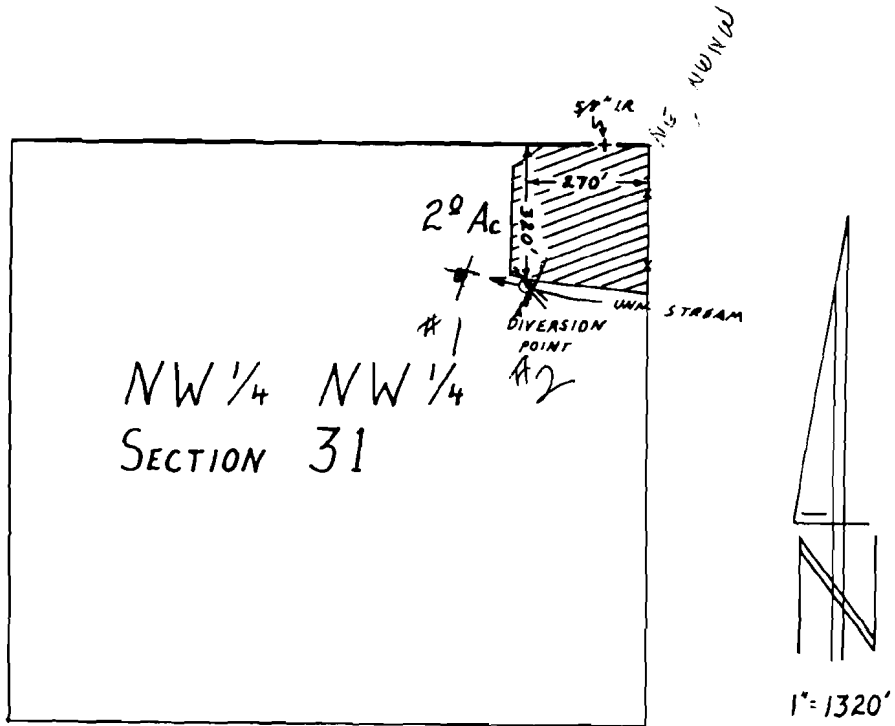

Application No. R-81388  
Permit No.

RECEIVED

AUG 08 1996

WATER RESOURCES DEPT.  
SALEM, OREGON

FINAL PROOF SURVEY

UNDER

Application No. 65158 Permit No. 47583  
IN NAME OF

VICKI WARD

Surveyed APRIL 12, 1991, by R.W. Klassen

SEE W/FF PAGE 2/27