

# Application No. R-77331 Permit No.

## SUBJECT PROPERTY MAP

JANUARY 1993


71008

"COMMUNICATE NO.

RECEIVED

JAN - 4 1993

WATER RESOURCES DEP  
SALEM, OREGON

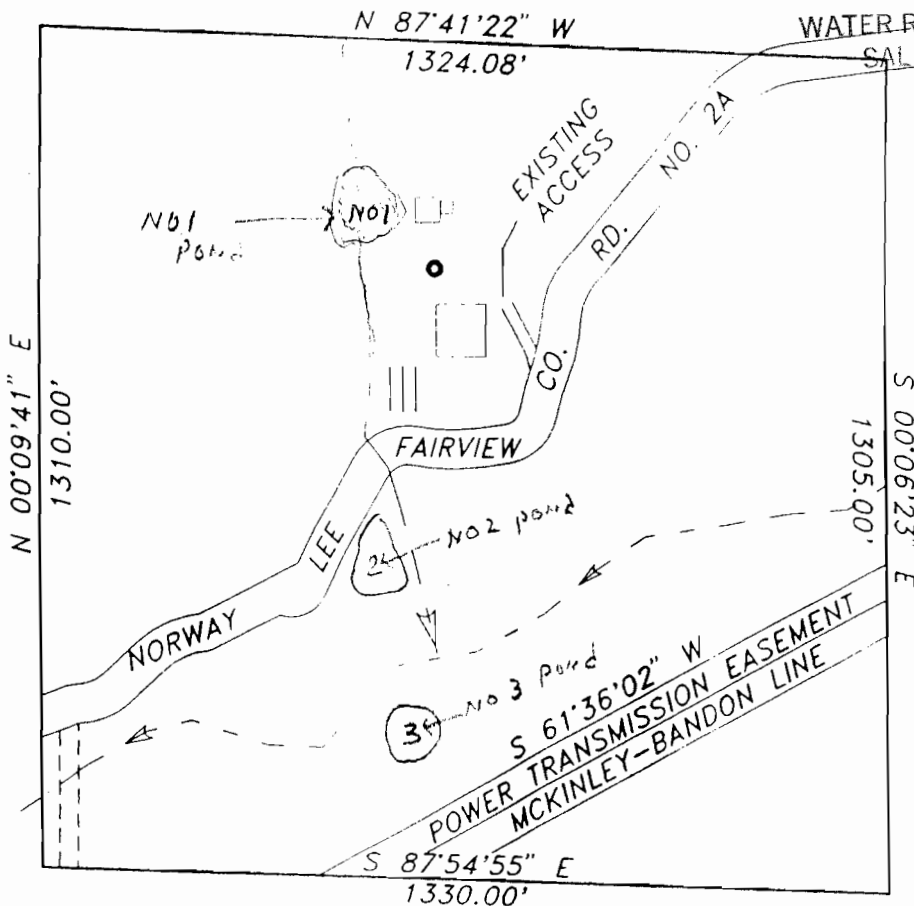

SCALE: 1"=300'

### LEGEND

- STREAM
- EXISTING BARN
- EXISTING WELL
- EXISTING DRAINFIELD
- FORMER AND PROPOSED DWELLING

*Stuntzner Engineering  
& Forestry*

---

ENGINEERING • LAND SURVEYING • FORESTRY  
PLANNING • WATER RIGHTS

705 South 4th St. Phone: (503) 267-2872  
Post Office Box 118 Coos Bay, Oregon 97420 Fax: (503) 267-0588

ATTACHMENT "A"  
9 of 9