

This map was prepared for assessment purpose only.

SECTION 15 T.3S. R.3E. W.M.


CLACKAMAS COUNTY

1" = 400'

D.L.C.

R. MATTOON NO. 47  
ALLEN MATTOON NO. 48  
NICHOLAS WELLS NO. 63  
GEO. HICINBOTHAM NO. 60  
ANSON J. WRIGHT NO. 58

3 3E 15

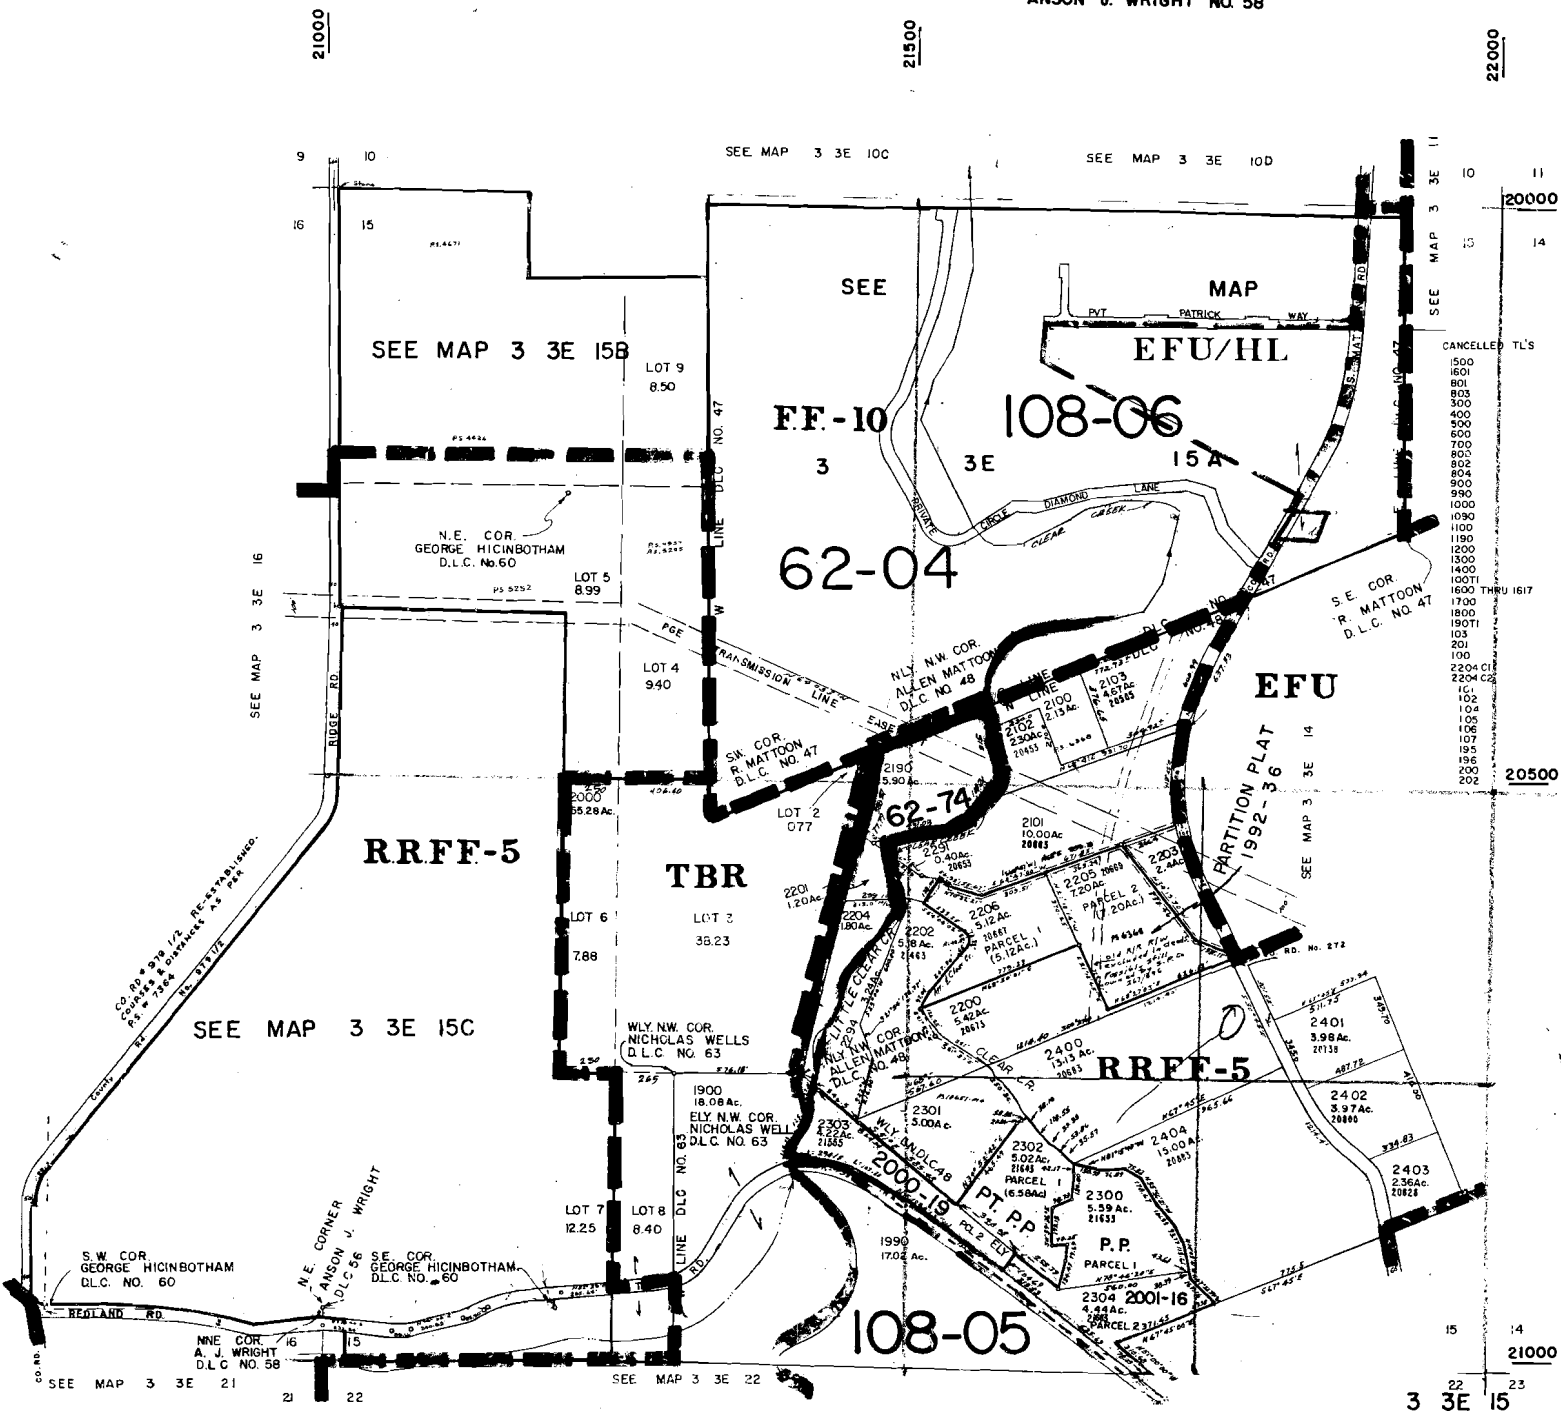

CANCELLED T.L'S

1500  
1601  
801  
803  
300  
400  
500  
600  
700  
800  
802  
804  
900  
990  
1000  
1090  
1100  
1190  
1200  
1300  
1400  
100T1  
1600 THRU 1617  
1700  
1800  
190T1  
103  
201  
100  
2204 CI  
2204 C2  
161  
102  
104  
105  
107  
195  
190  
200  
202

14  
15  
3 3E 15

BOOK 31

THIS MAP IS FURNISHED AS A CONVENIENCE IN LOCATING PROPERTY AND THE COMPANY ASSUMES NO LIABILITY FOR ANY VARIATIONS AS MAY BE DISCLOSED BY ACTUAL SURVEY




# First American Title Insurance Company of Oregon

an assumed business name of TITLE INSURANCE COMPANY OF OREGON  
16220 SE McLoughlin Blvd. • Milwaukie, Oregon 97267

503-653-7000



MAP # 3338 15

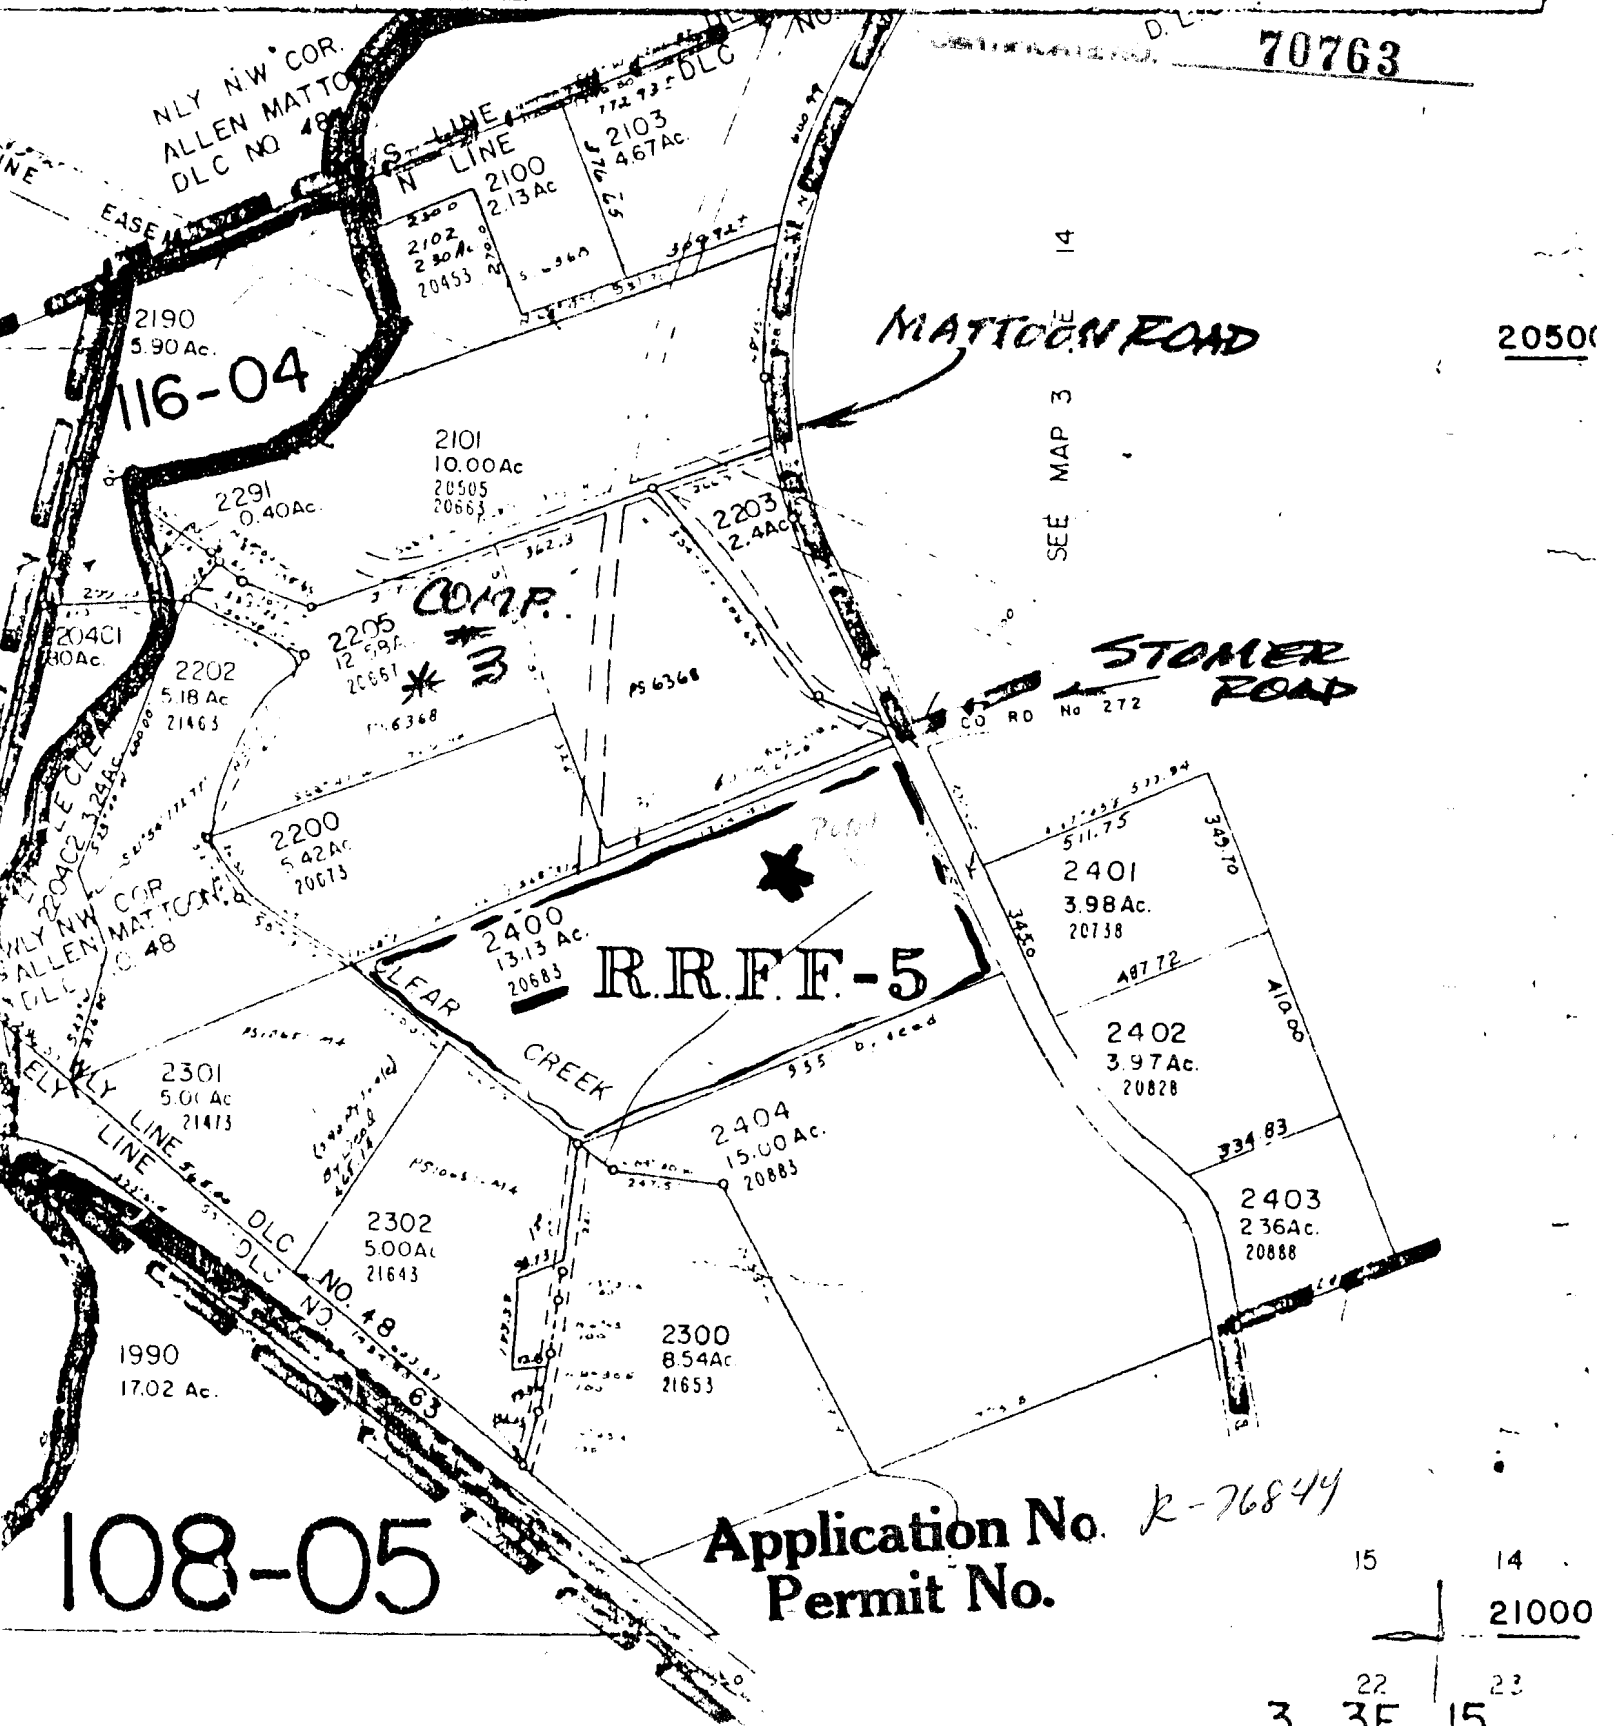

70763

20500

SEE MAP 3 14

MATTOON ROAD

STONER ROAD

RRFF-5

108-05

Application No. *k-76844*  
Permit No.

15 14  
21000

3 22 23  
3 3F 15