

"CERTIFICATE NO. 70646

TWP 3S R30E W.M.

UMATILLA COUNTY

RECEIVED


Application No. R-70724

1" = 2000'

Permit No.

SEE MAP 2S 30E

DEC 30 1994
WATER RESOURCES DEPT.
SALEM, OREGON

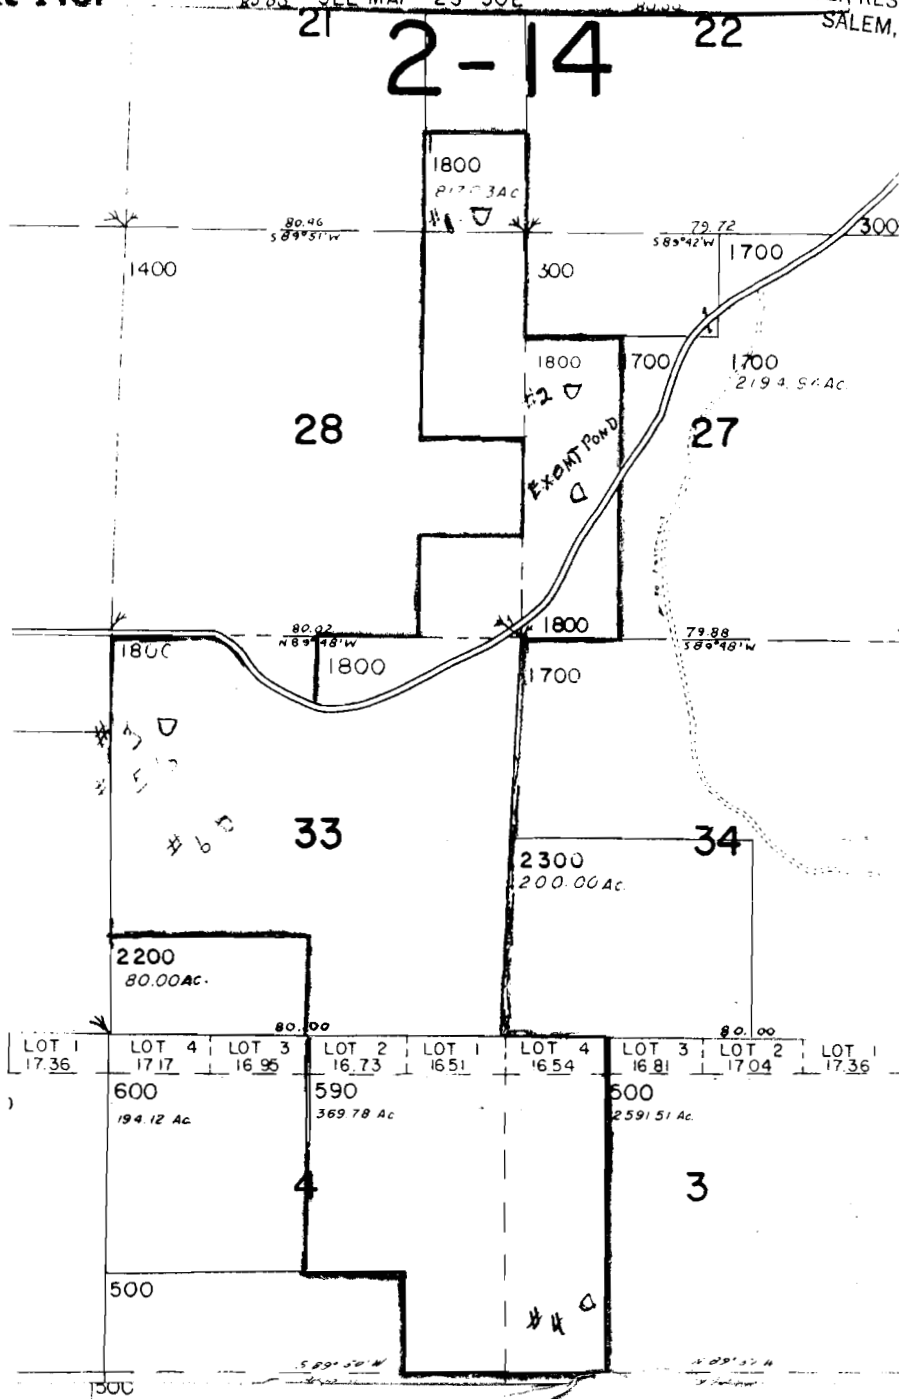

R.30E.W.M.

UMATILLA COUNTY

1" = 2000'

See Map 3S 30

