


LANE COUNTY


1" = 200'

LINN COUNTY

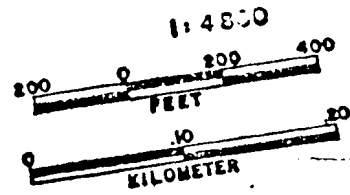

69894

SEE MAP 16-02-10-2

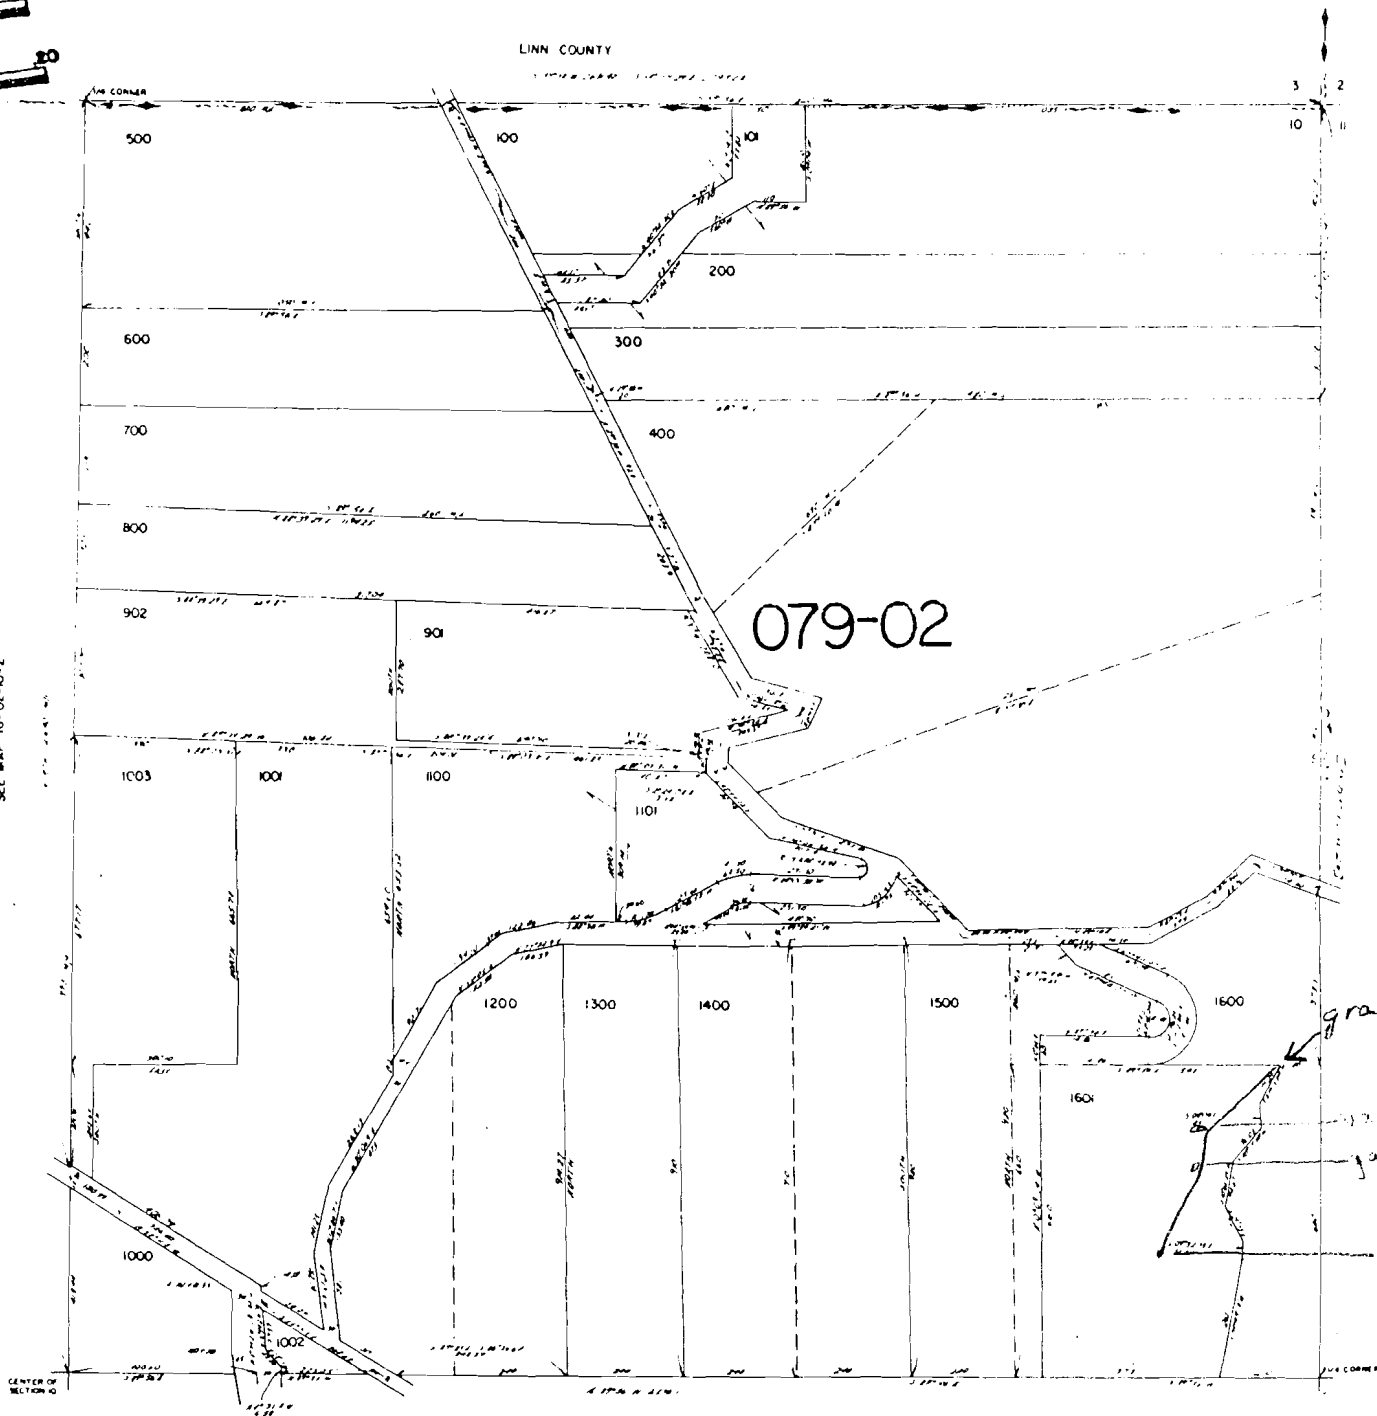

SEE MAP 16-02-11-2

16 02 II

gravity flow pipe
road & flower garden
ponds