


Bonds #:
 7, 8, 10, 11, 12, 13,
 14, 15, 16, 28, 29,
 30, 54, 55

35227E

SEC 19
 24-25-26-27-28-29-30
 1-02

SEC 19
 24-25-26-27-28-29-30
 1-02

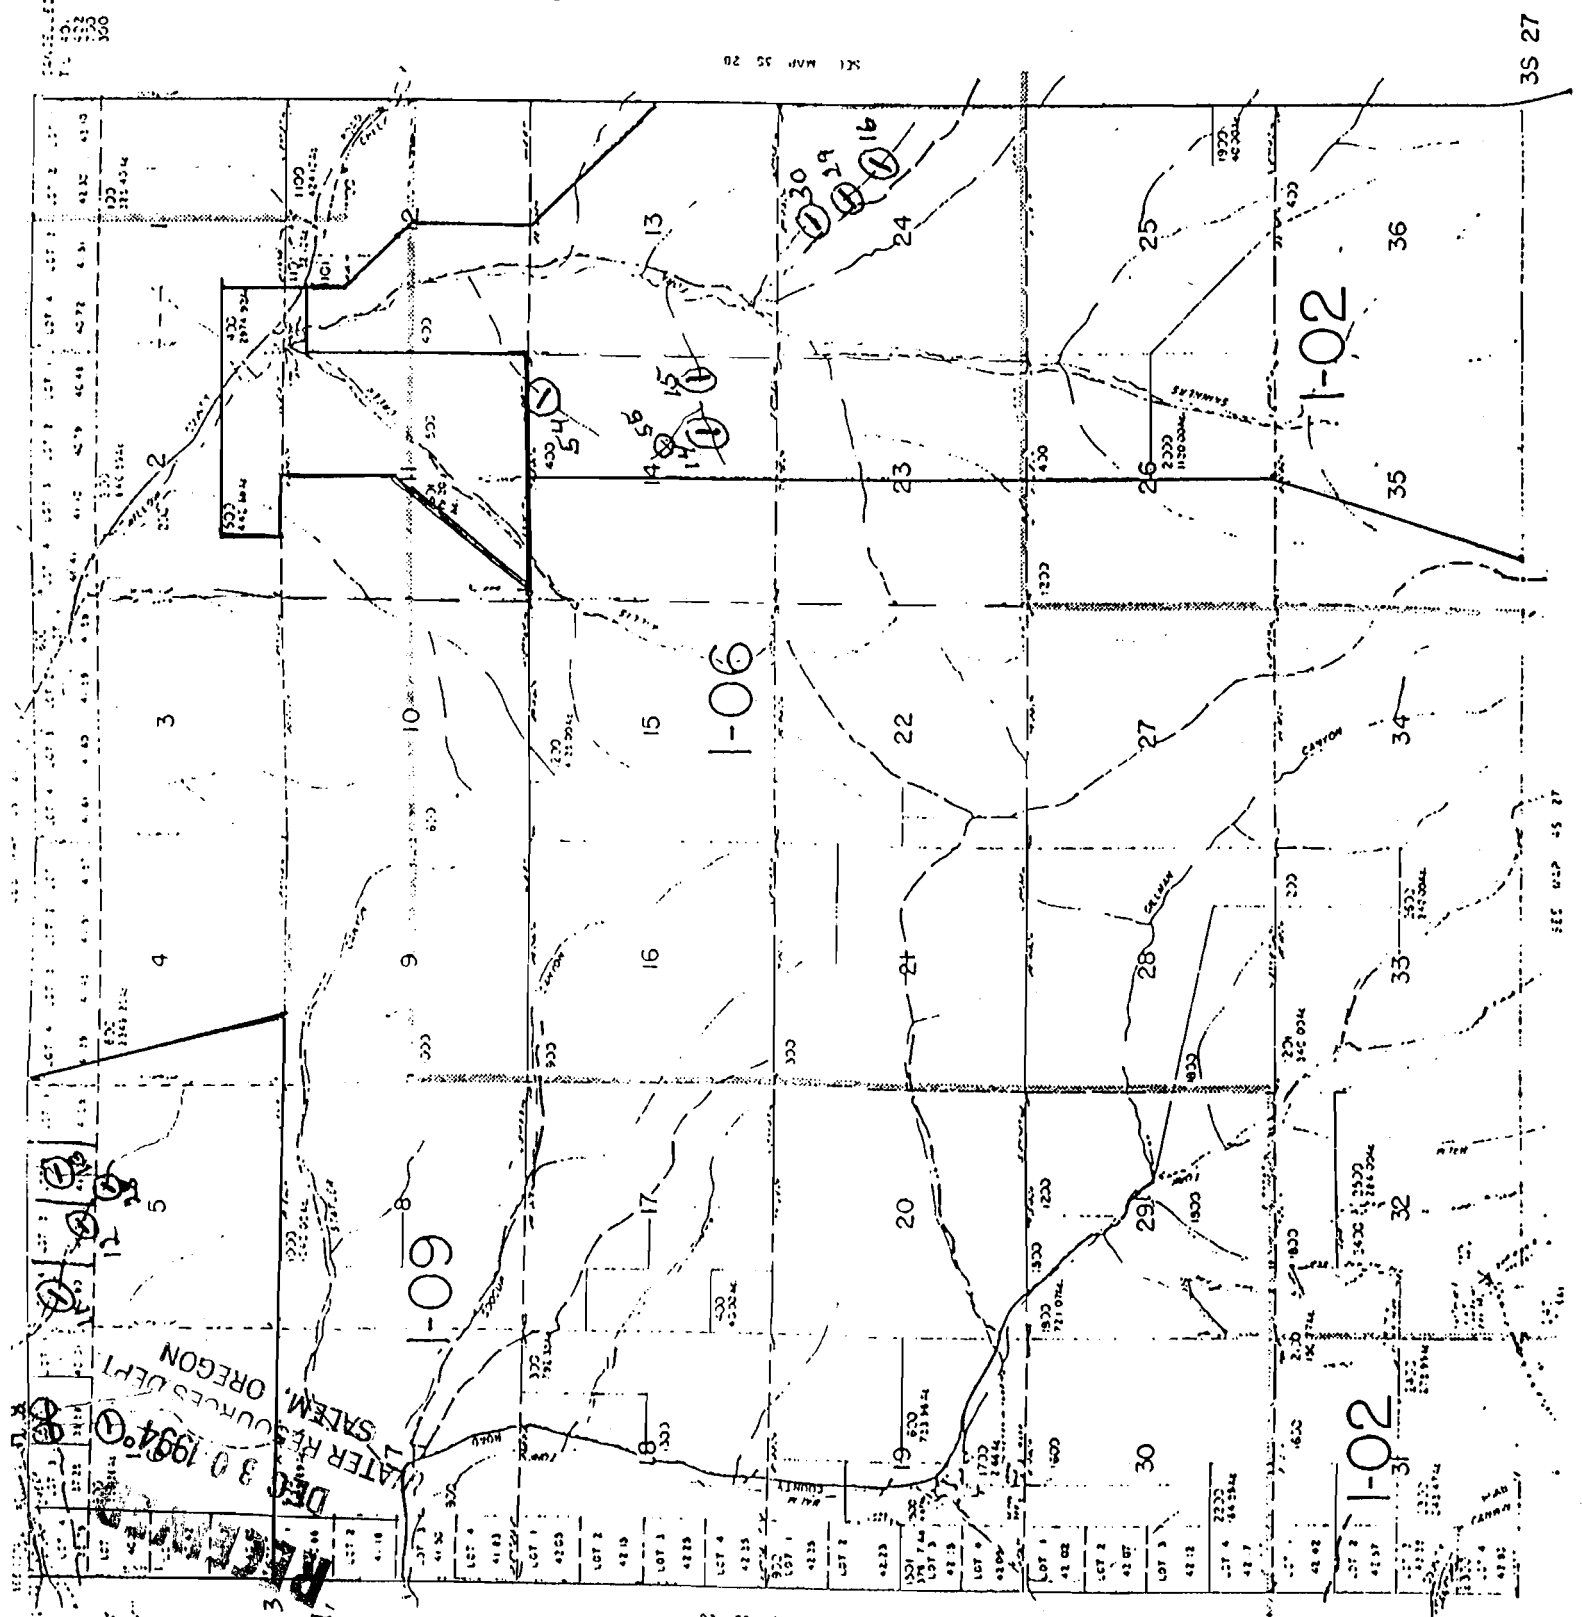


Application No F-81583
 Permit No.

Ponds #:

17, 18, 19, 20, 21,
22, 23, 24, 31, 32,
33, 34, 35, 36,
37, 38, 39, 40, 41
42, 43, 44, 45, 46
47, 48, 49, 50, 51
52, 53

3528E

RECEIVED
DEPT. OF LAND
SALES
JAN 9 1994
OREGON

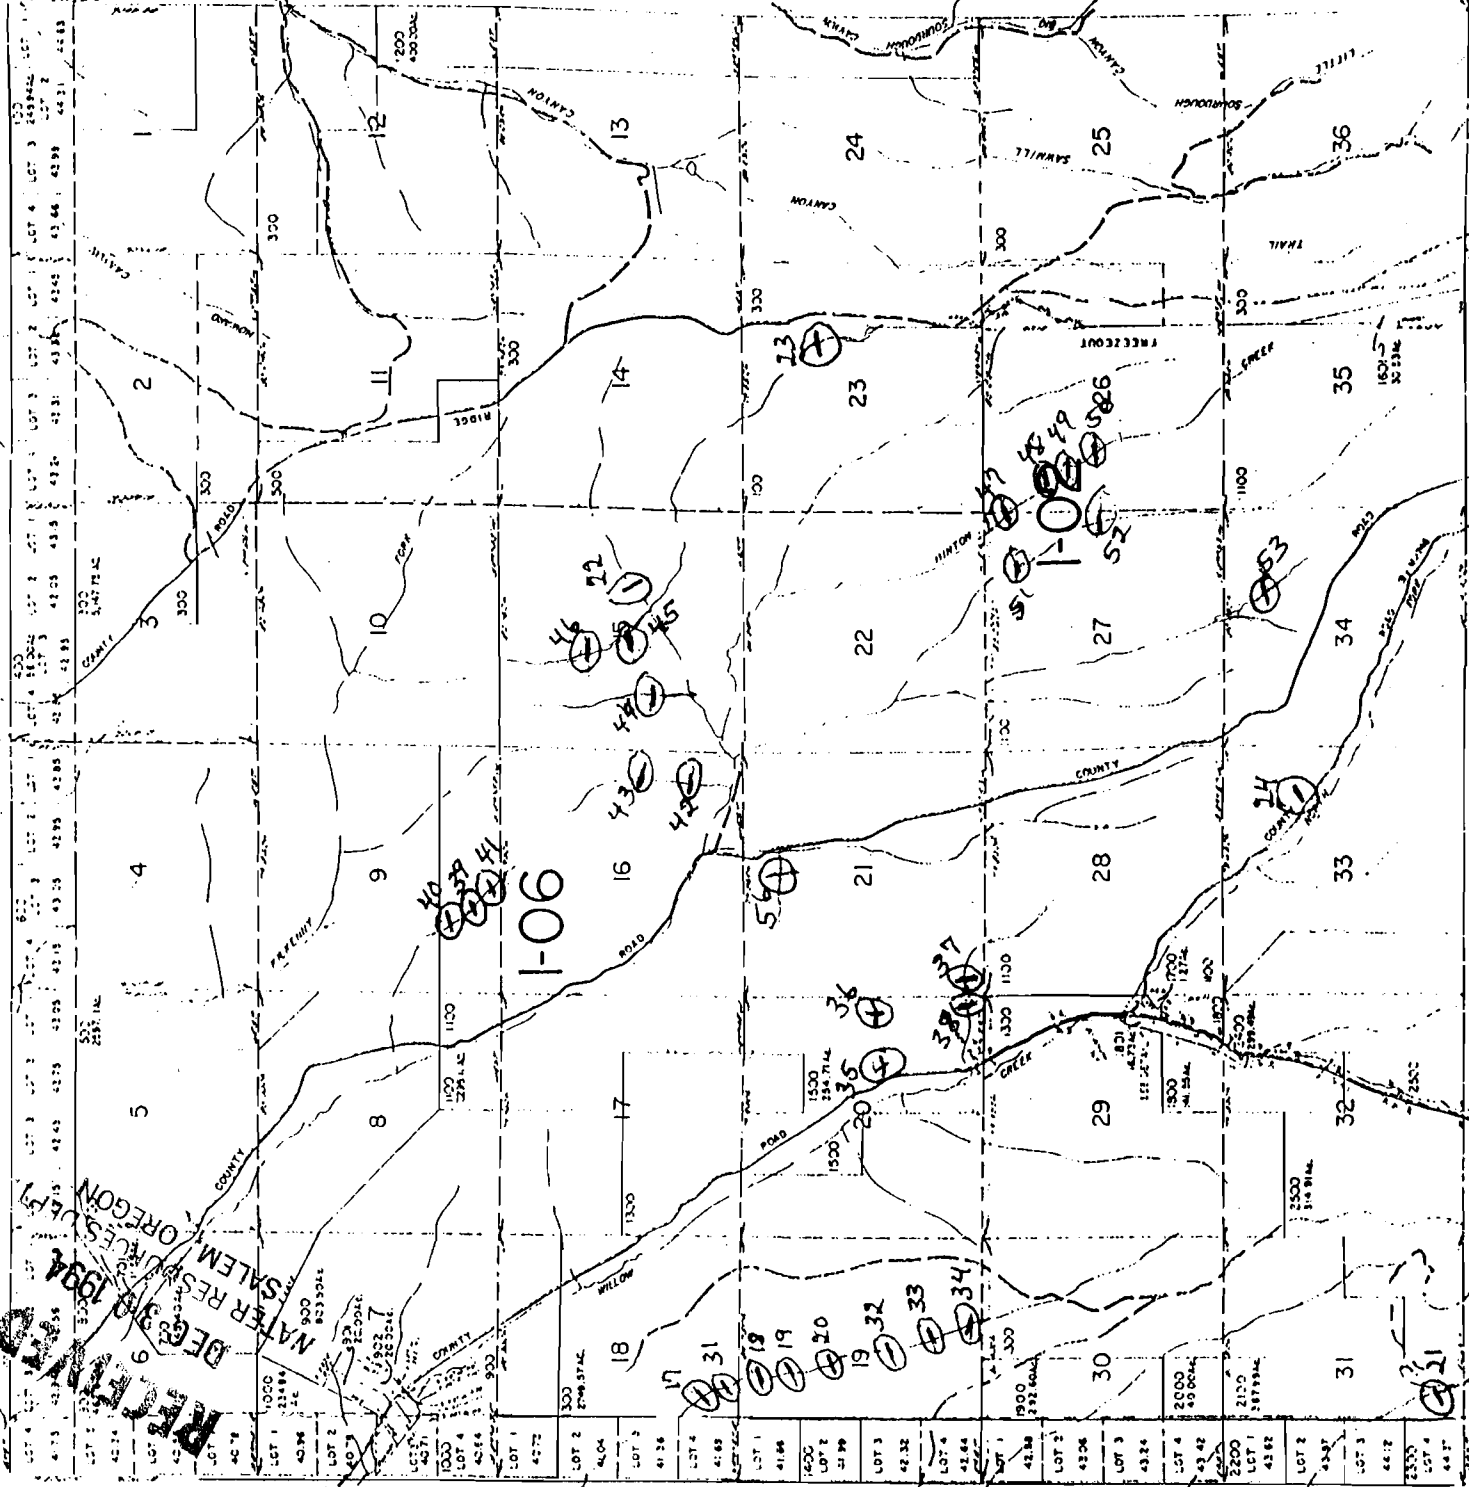

Application No. 28,1583
Permit No.

SEE MAP 35 29

3S 28

SEE MAP 35 28