



Penny Spring #3
T4S R 35 E

R. 79661

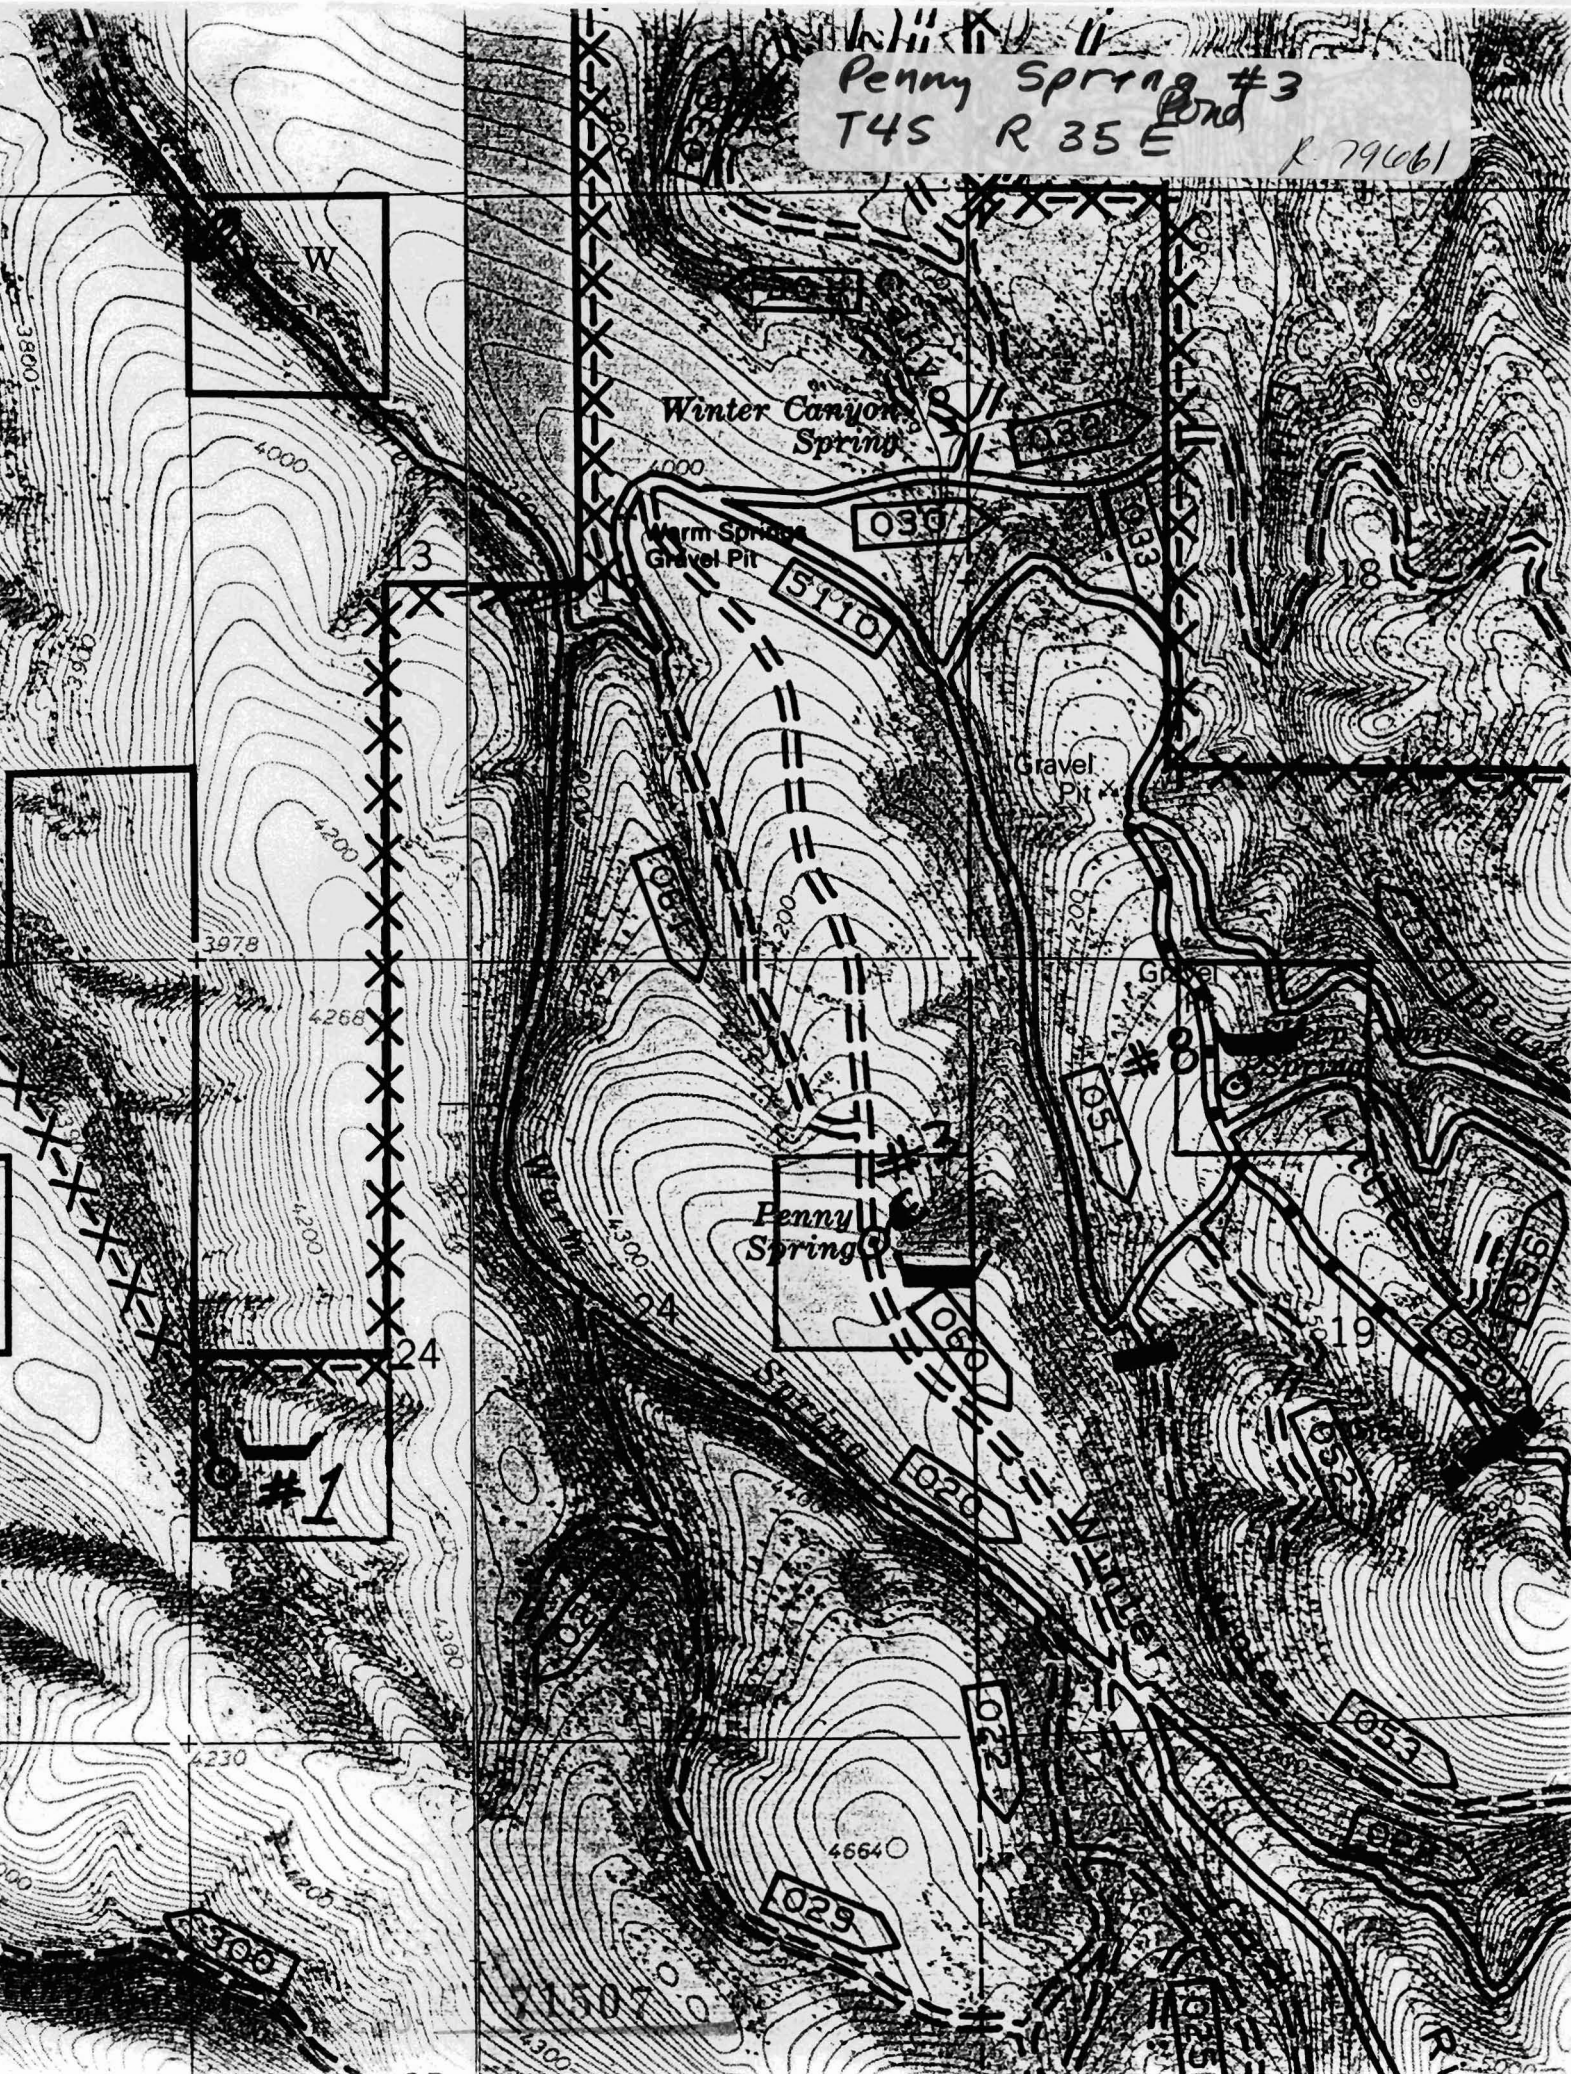




R. 79661

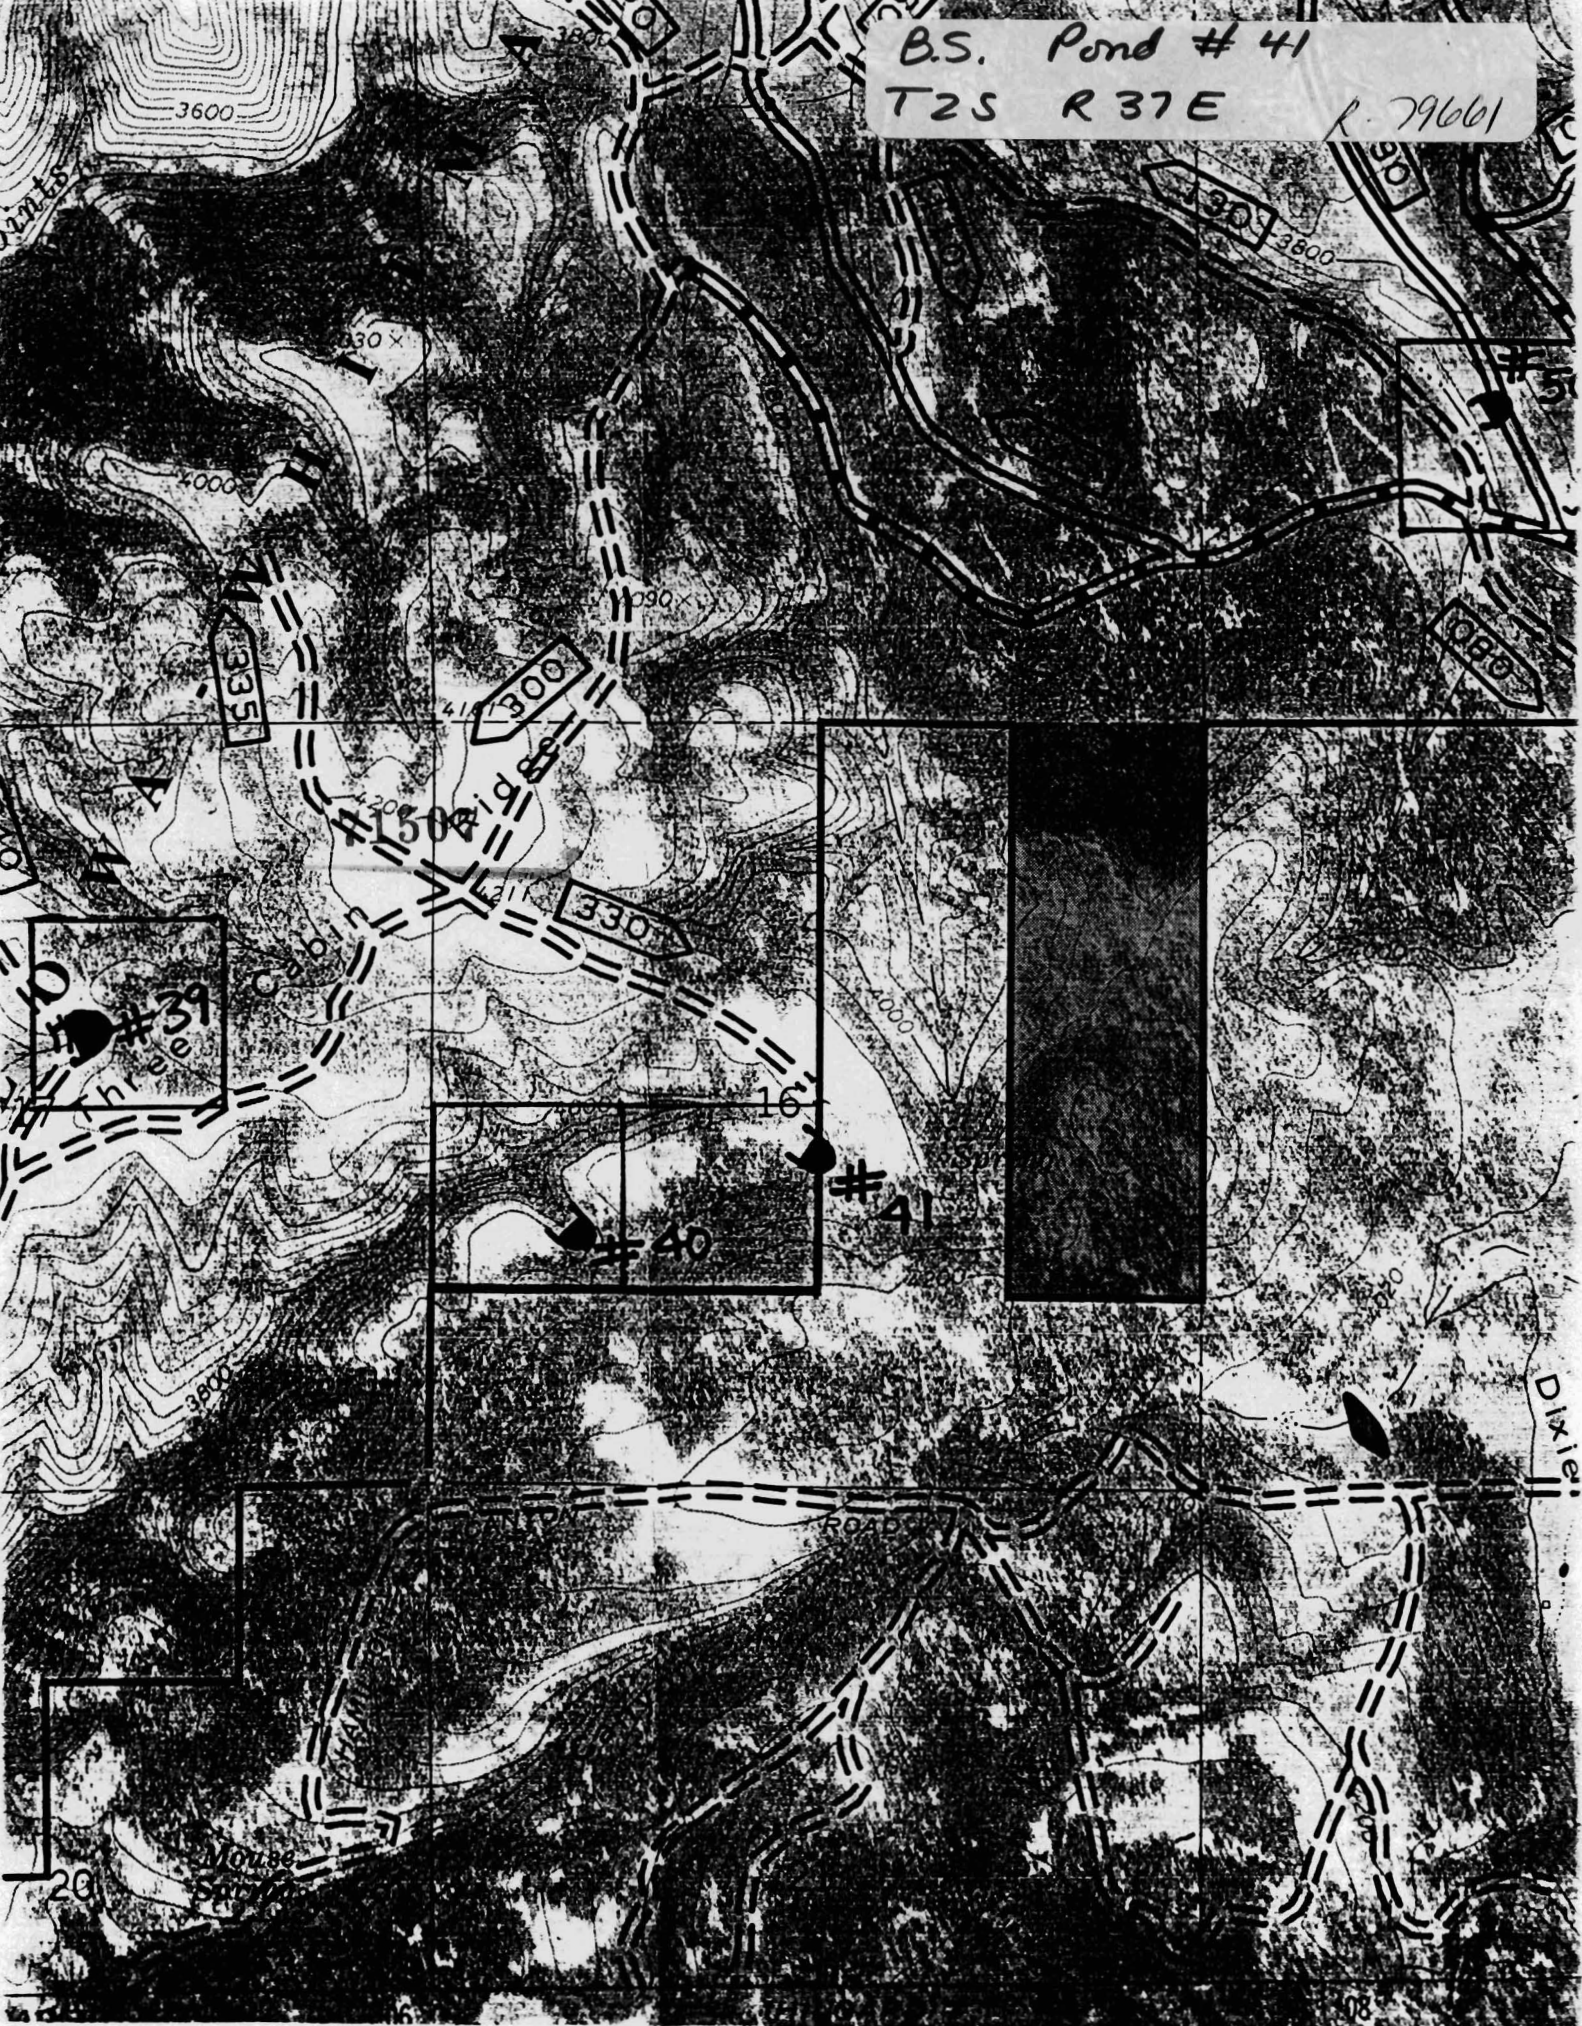

GRADE
C10

Thimble Pond #44
T 2 S R 37 E R. 79601

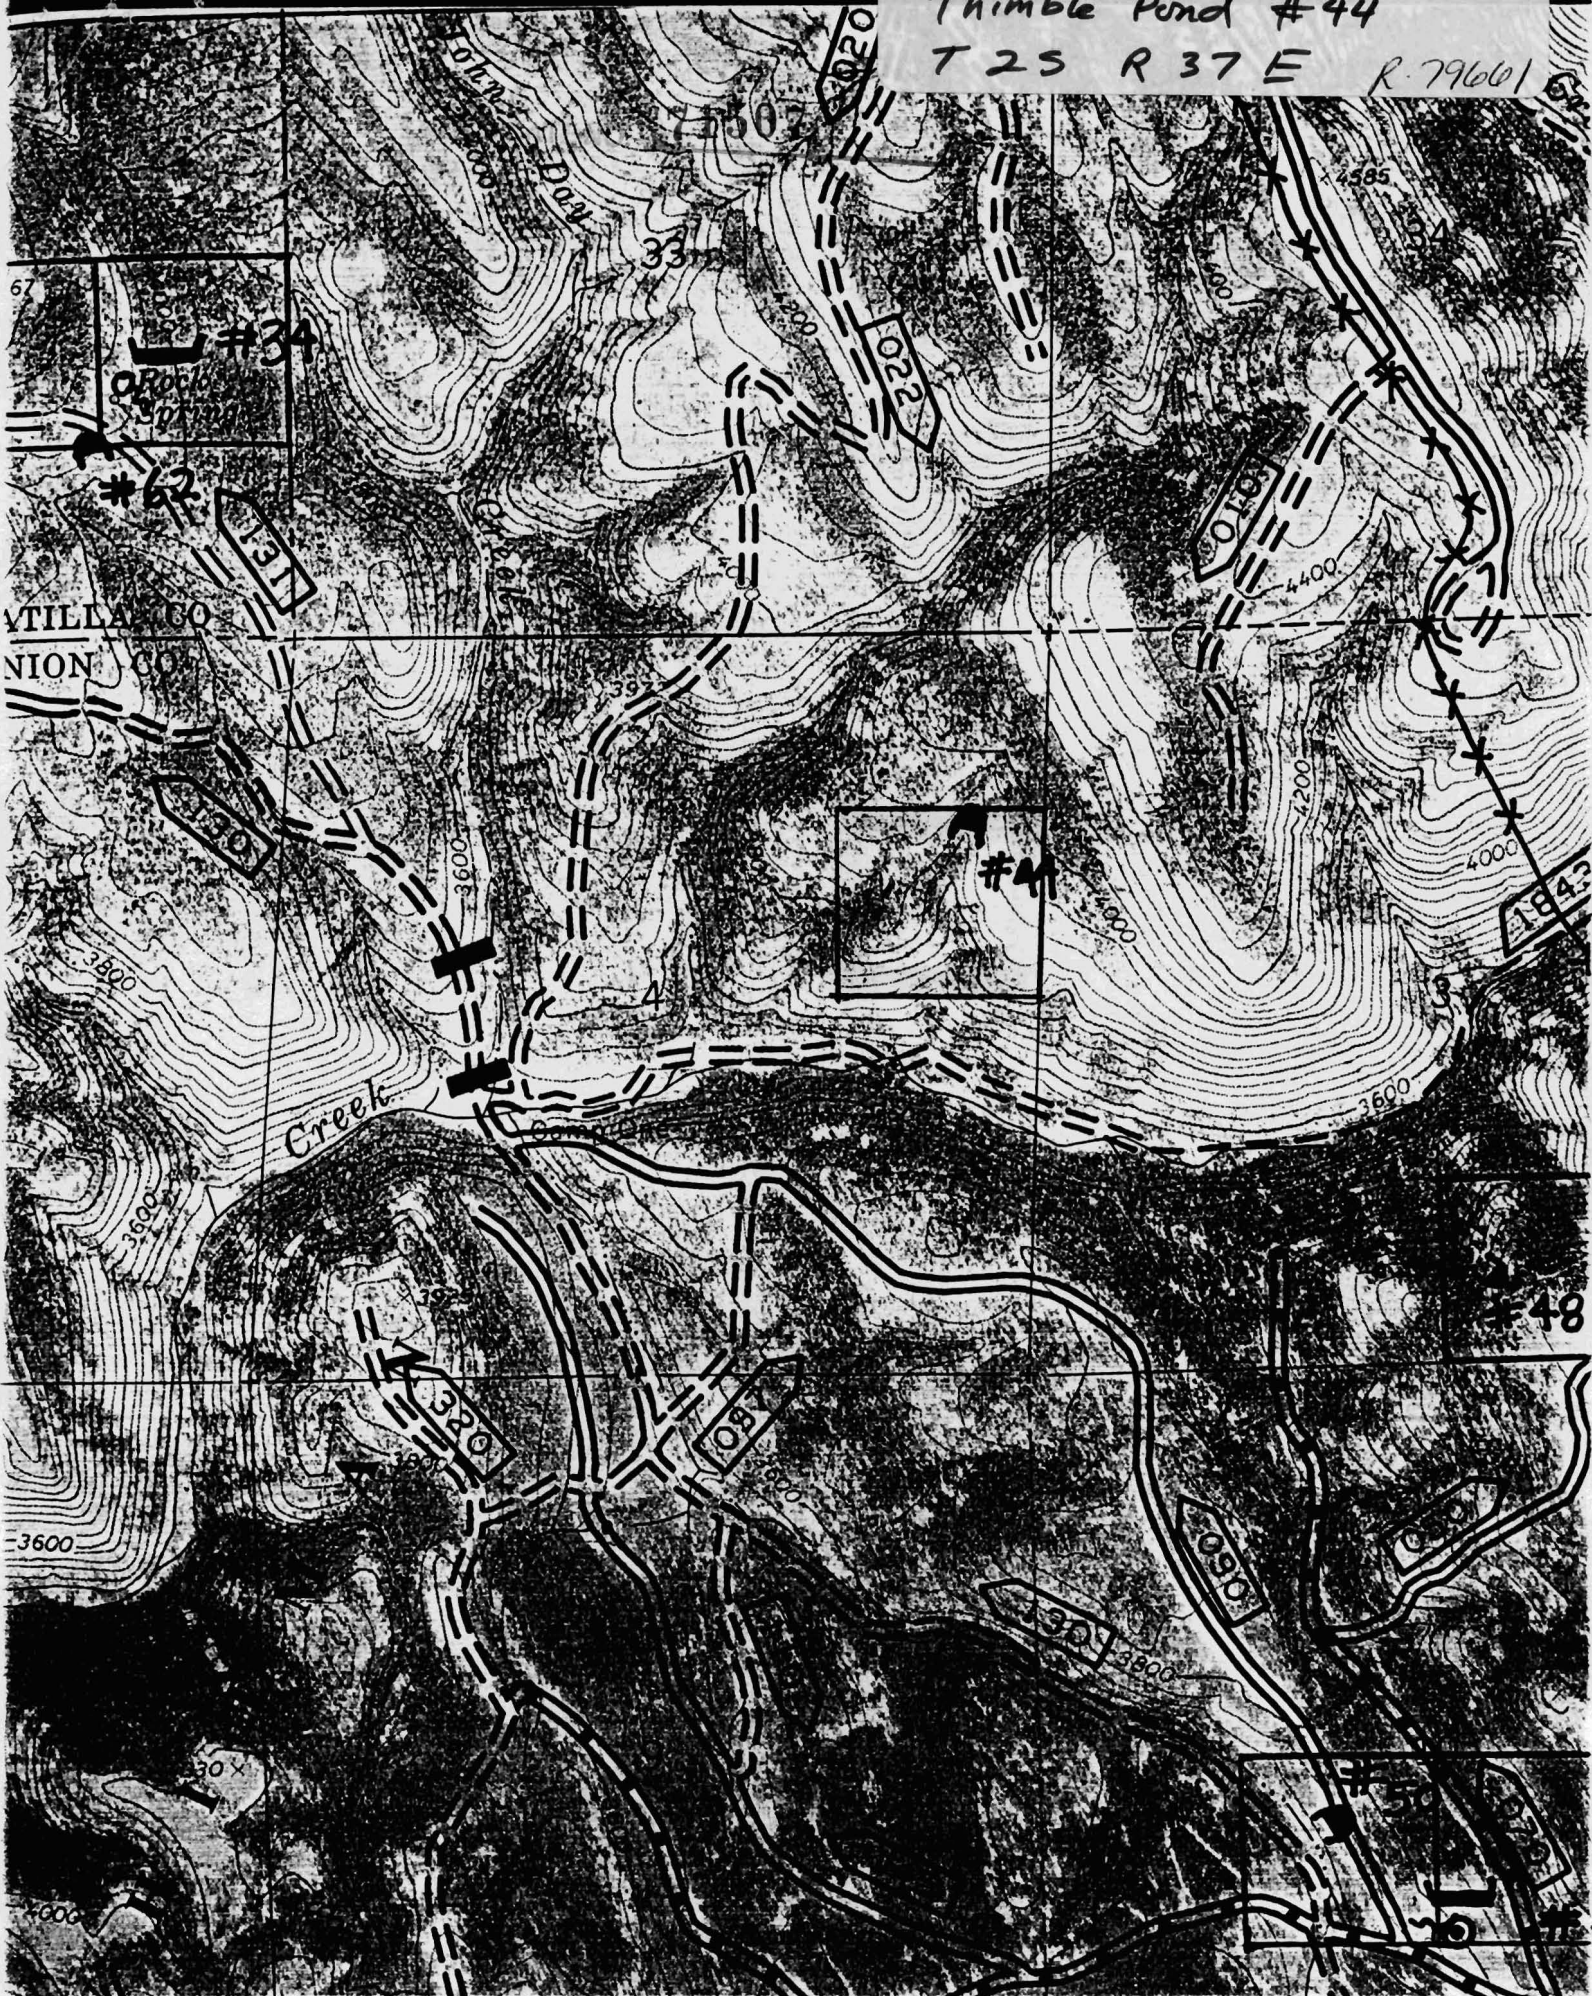

T2S R37 E R.79661 X

T2S R37 E R.79661 X




71507

Prairie

Rail Road Grade Pond #52

T2S R36E


R 79601

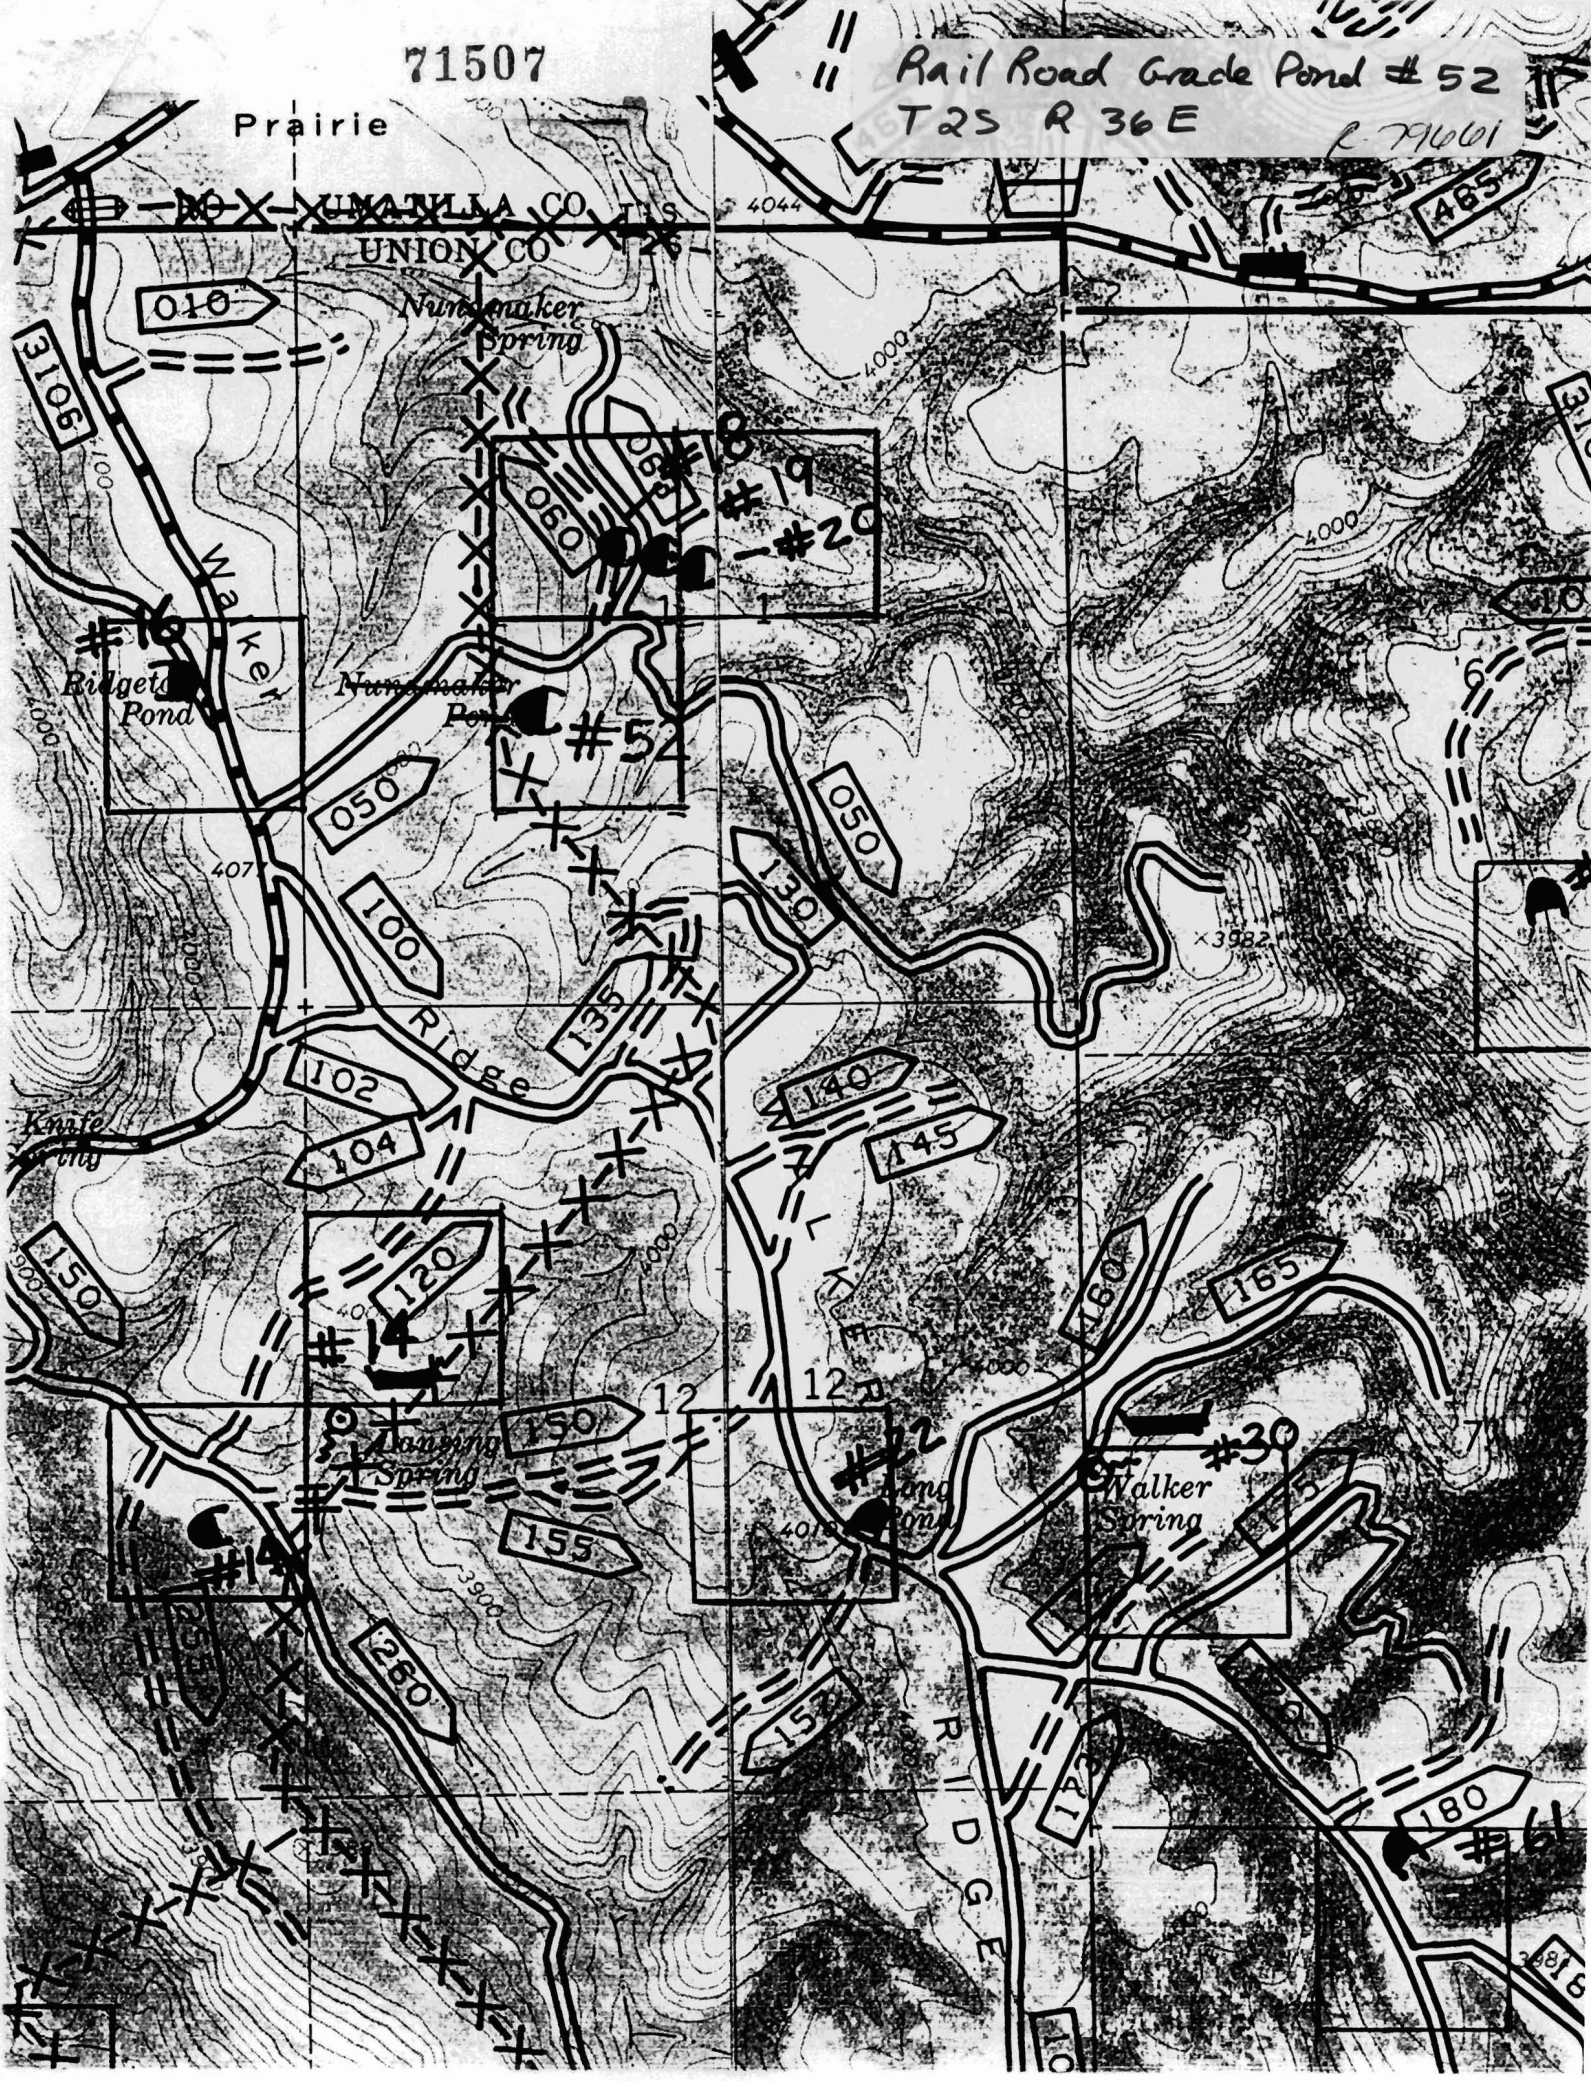

McClure Pond #50
T2S R37E L79661



~~Walker~~ Pond #1 (#61)
Alexander
T2S R 37E R. 79661

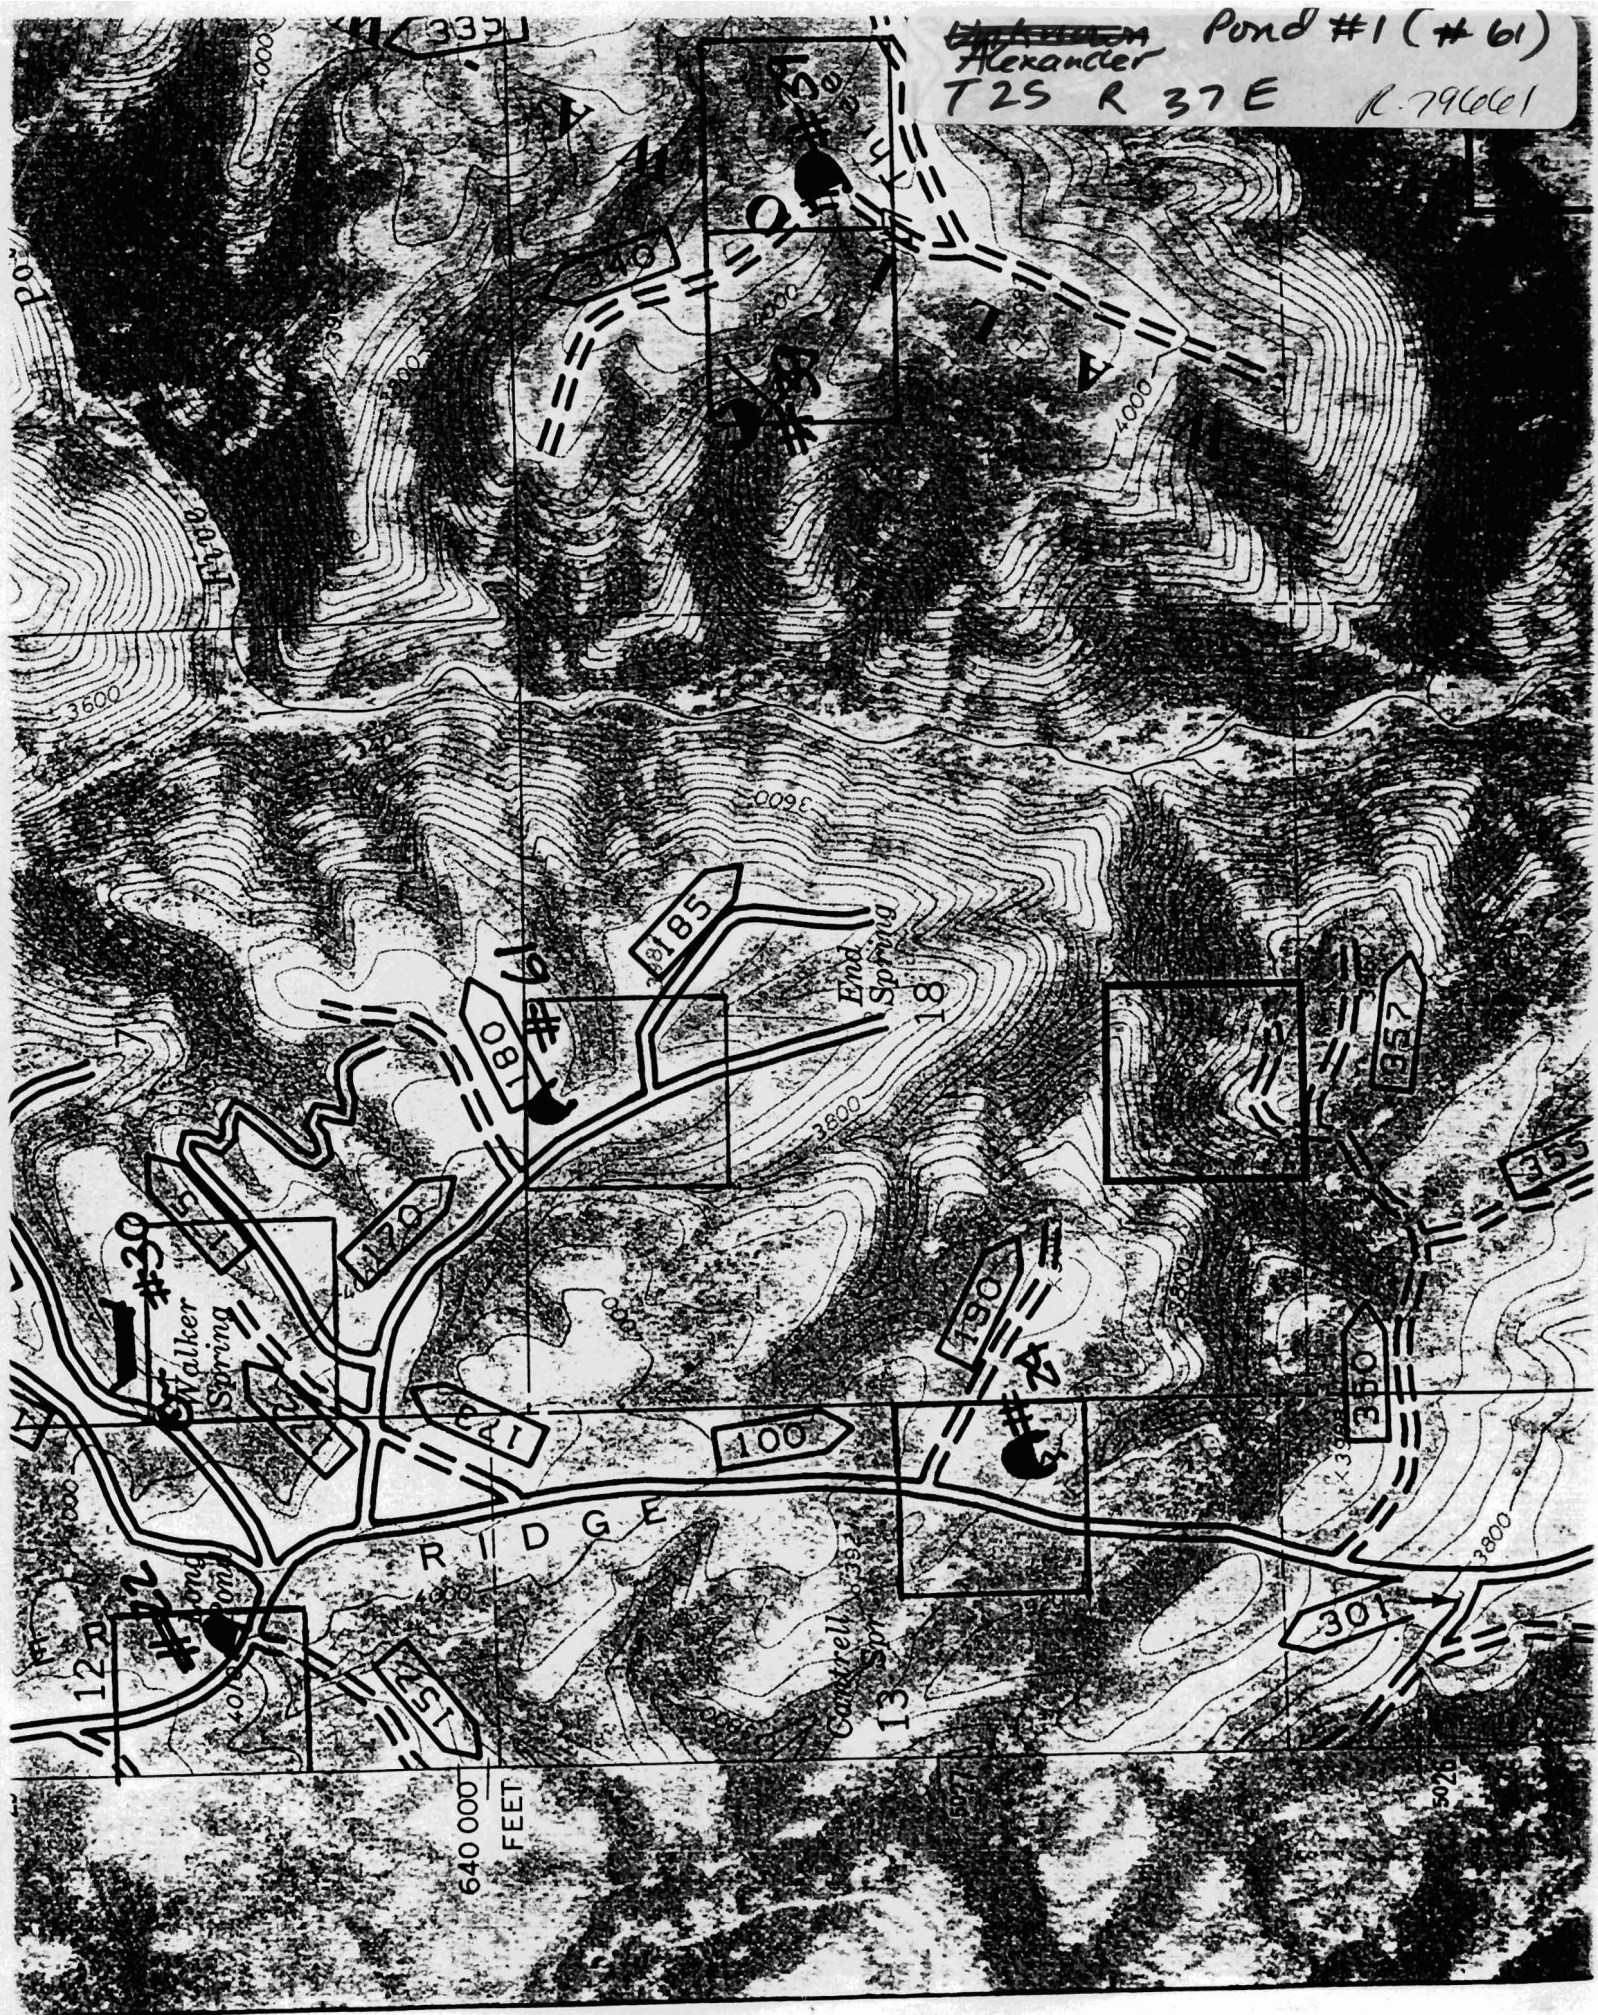

Application No. R. 79661
Permit No. 71507

Unknown Pond # 62
(Rock Sp. Pond) # 62
T 1 S R 37 E

