


T. 40S., R. 14W., W.M.

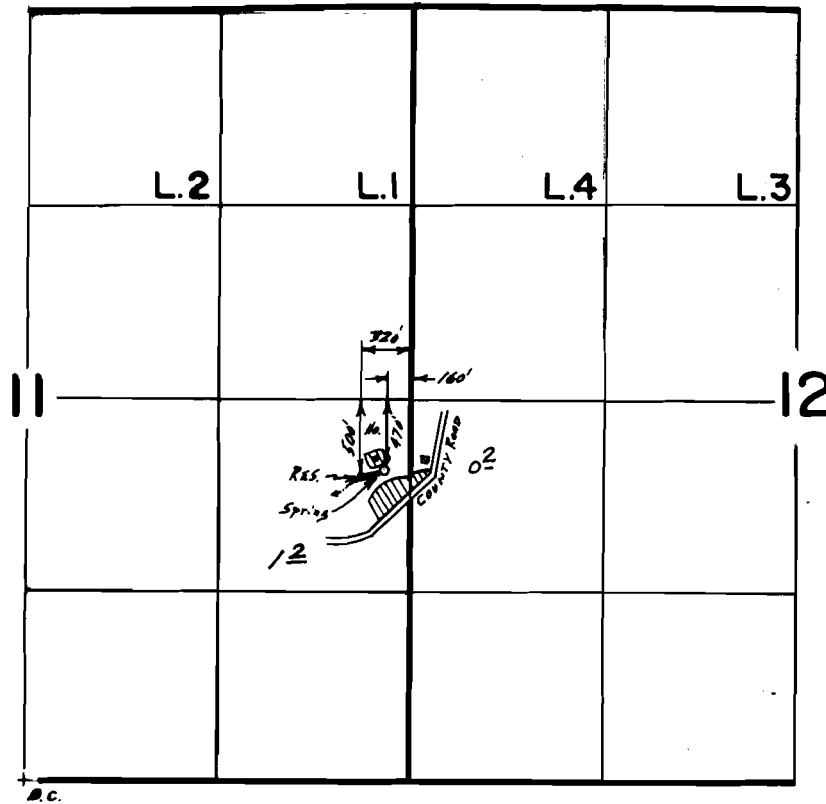

Scale 1" = 1320'

FINAL PROOF SURVEY
UNDER

R-53048 R-6423
Application No. 53049 Permit No. 40314.....
IN NAME OF

.....LEE J. RIDDLE.....

Surveyed May 19, 1987, by J.M. SCHMORDE