


T.13S.R. 26E.W.M.

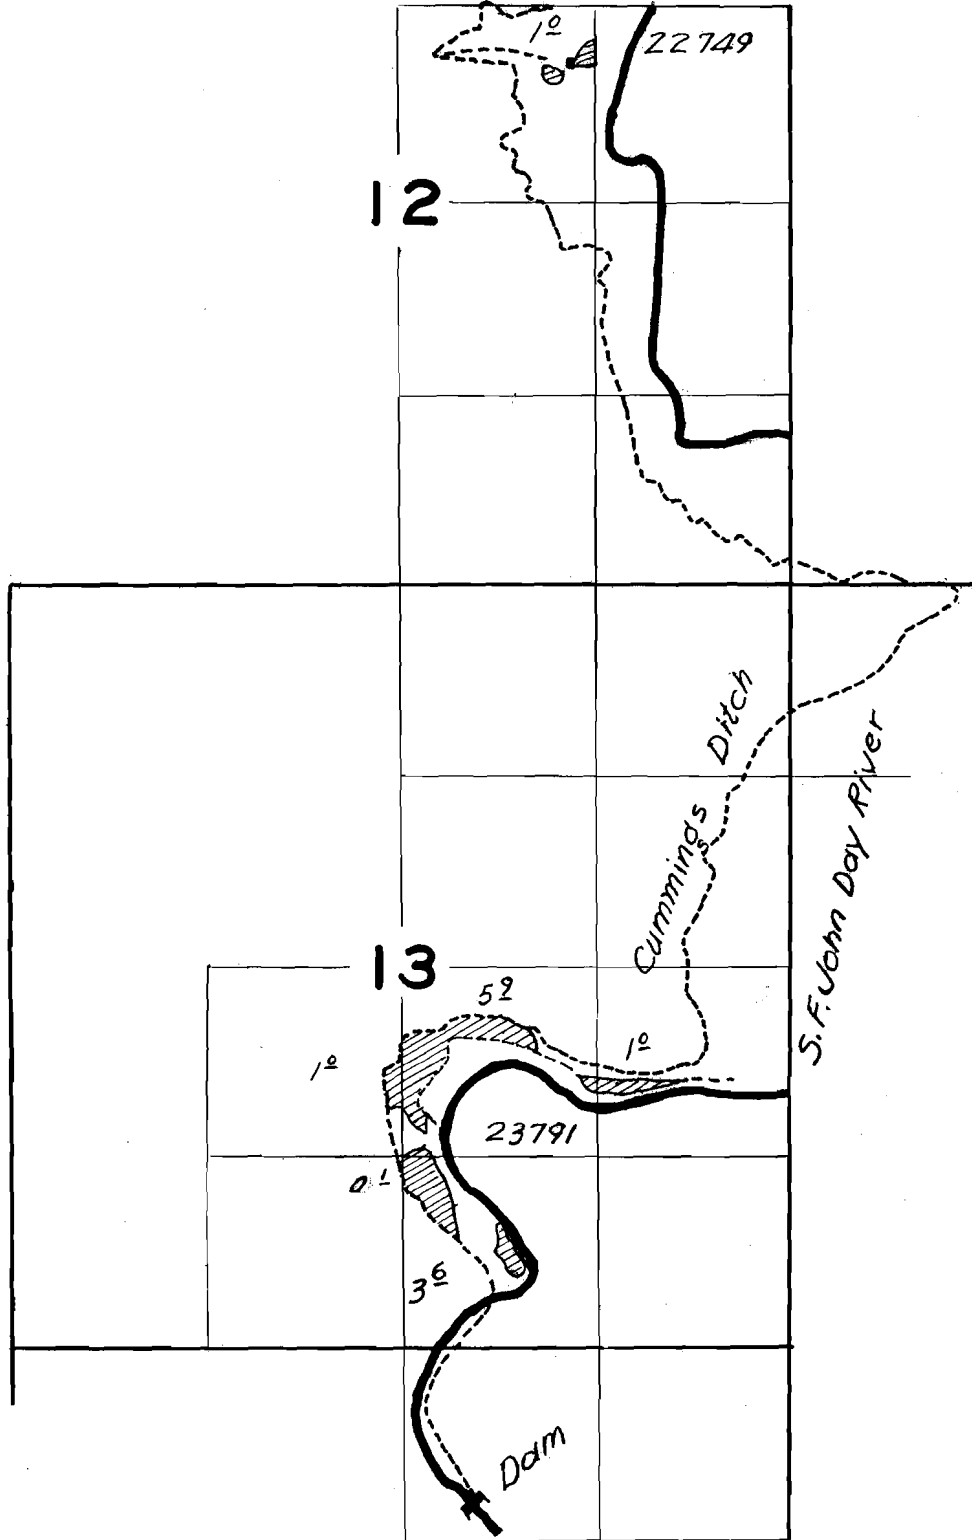

FINAL PROOF SURVEY

George S. Black
Geo. MacArthur

Appl. 22749 Permit 17862
23791 18768

24

Surveyed August 29, 1954 by H. L. Coffman

G6-4
G5-7
Pantograph