


T.26S.,R.16E.,W.M.

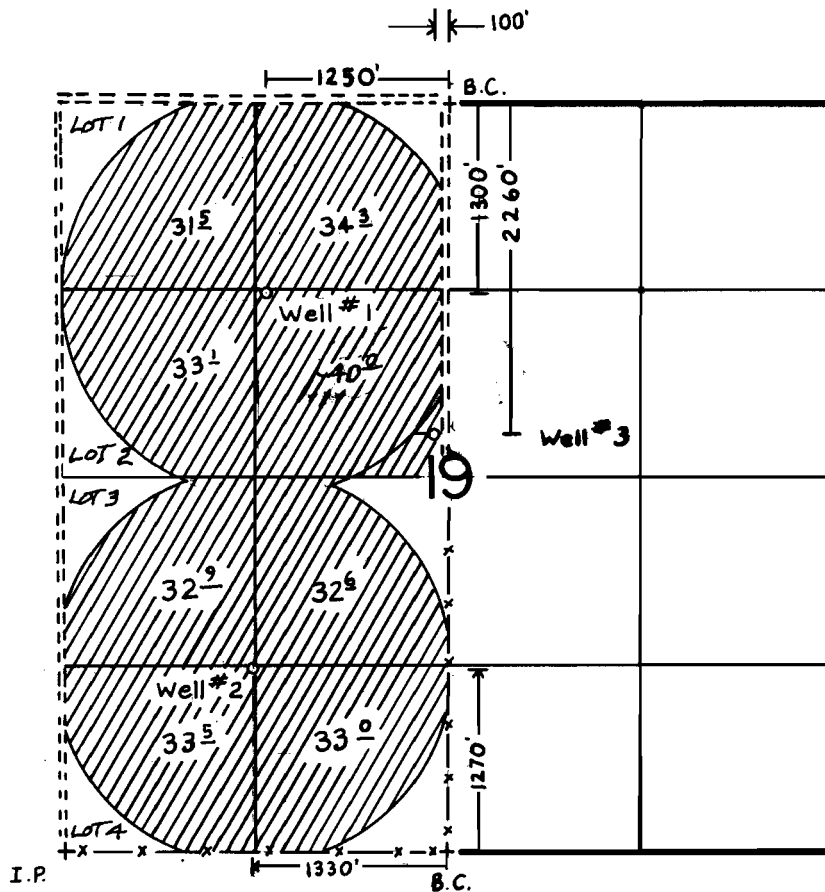

FINAL PROOF SURVEY
UNDER

Application No. G-8601.. Permit No. G-8060....
IN NAME OF

ROY L. FORMAN

Surveyed MAY 16.... 1985., by LESLIE OLSON....