
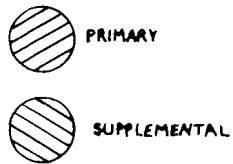


# T. 6 N. R. 33 & 34 E. W.M.

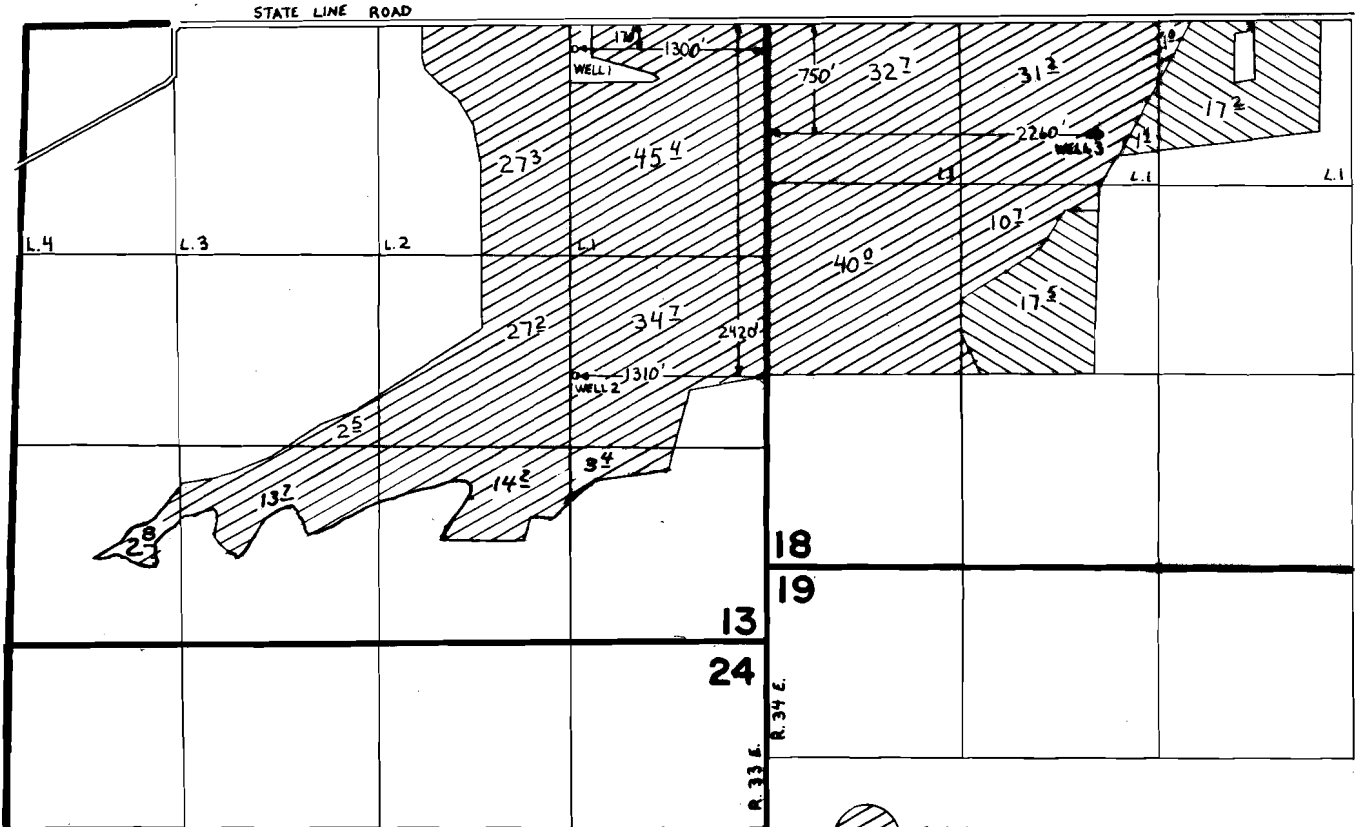

## FINAL PROOF SURVEY UNDER

Application No. G.8422 Permit No. G.7826.....  
IN NAME OF

**BURLINGAME LAND & LIVESTOCK, INC.**

Surveyed March 2, 1987, by V. Church.....



Scale 1" = 1320'