


T.1N., R.40E., W.M.

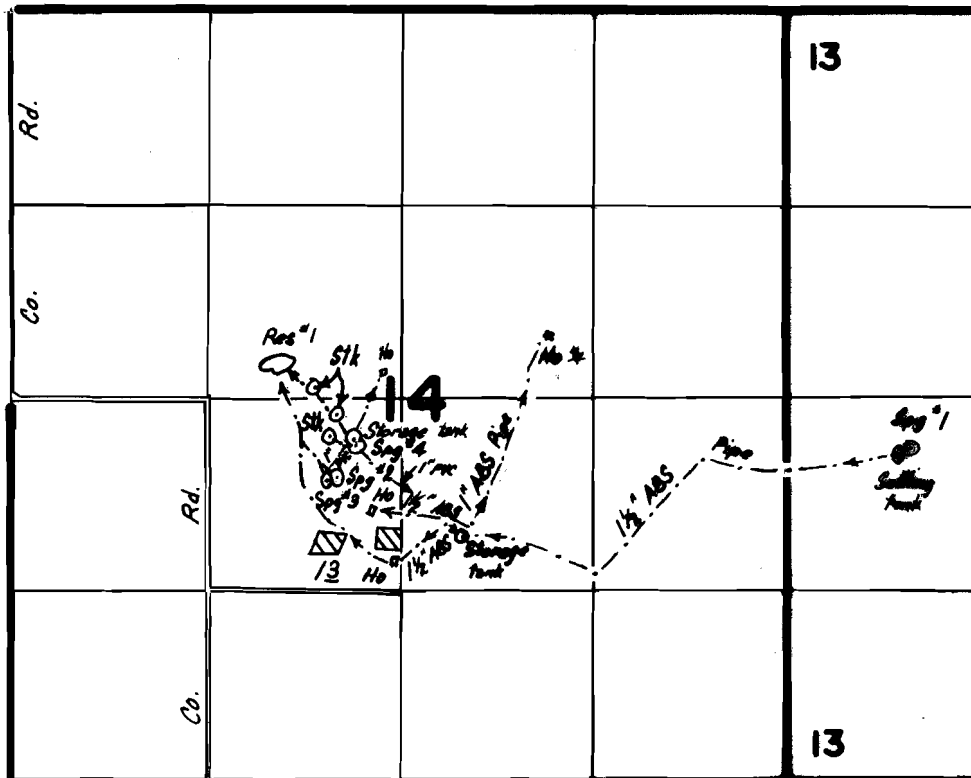

Location of : Spring #1 - 2280' N. & 850' E. ;
 Spring #2 - 2100' N. & 3050' W. ; Spring #3 -
 2060' N. & 3110' W. ; Spring #4 - 2300' N. &
 2930' W. ; all from SE cor. sec. 14.



Scale: 1" = 1320'

FINAL PROOF SURVEY
 UNDER

R-52511 R-6378
 Application No. 52512... Permit No. 39806...
 IN NAME OF

ESTILL...J. ARRAND...&...THOMAS...E. DACUS

Surveyed ...4-12... 1988., by ...Vern. Church.....