


T.10&11 S., R.9 W., W.M.

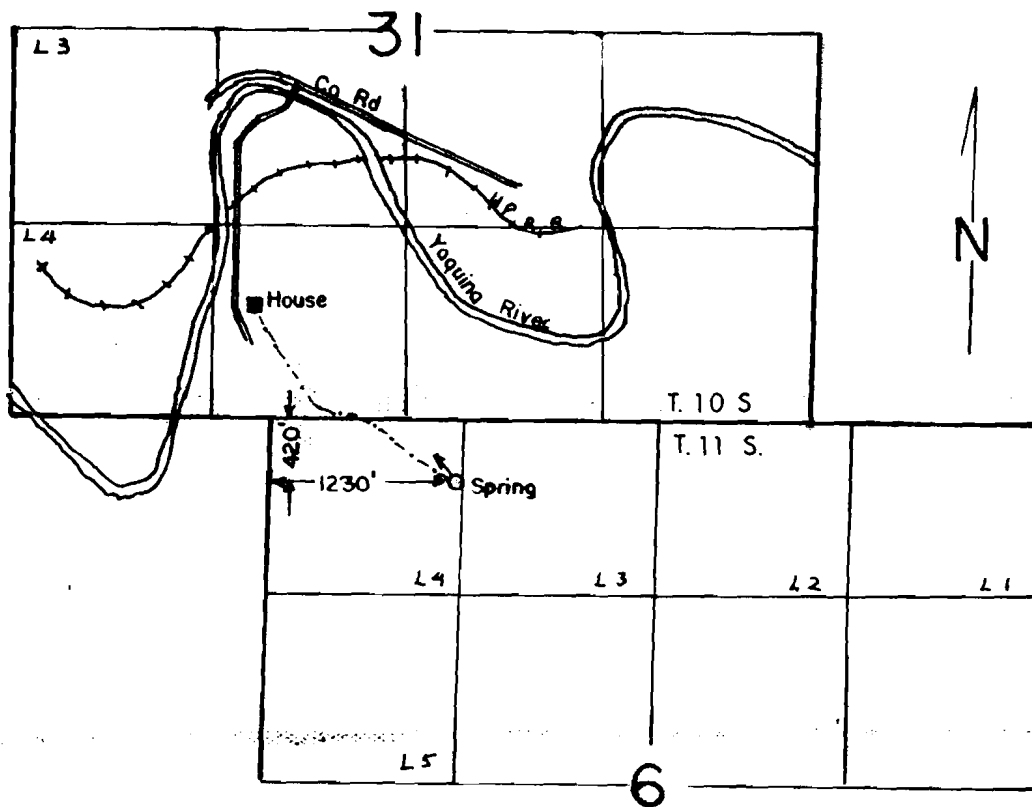

SCALE: 1"=1320

FINAL PROOF SURVEY
UNDER

Application No. 58808 Permit No. 44853
IN NAME OF

RAYMOND L. KINION

Surveyed NOV. 5, 1987, by J.M. WARREN