

Form A1-187
March 1961
SECTION


RECEIVED

WATER RESOURCES DEPT.
SALEM, OREGON

32
Sec 6
~~54~~ ~~54 1/2~~
NWNE

TOWNSHIP 29S, RANGE 29E, W. M.

NAME _____
 Given as with record ^(North) photo: 25.4.6 Bud Hogg

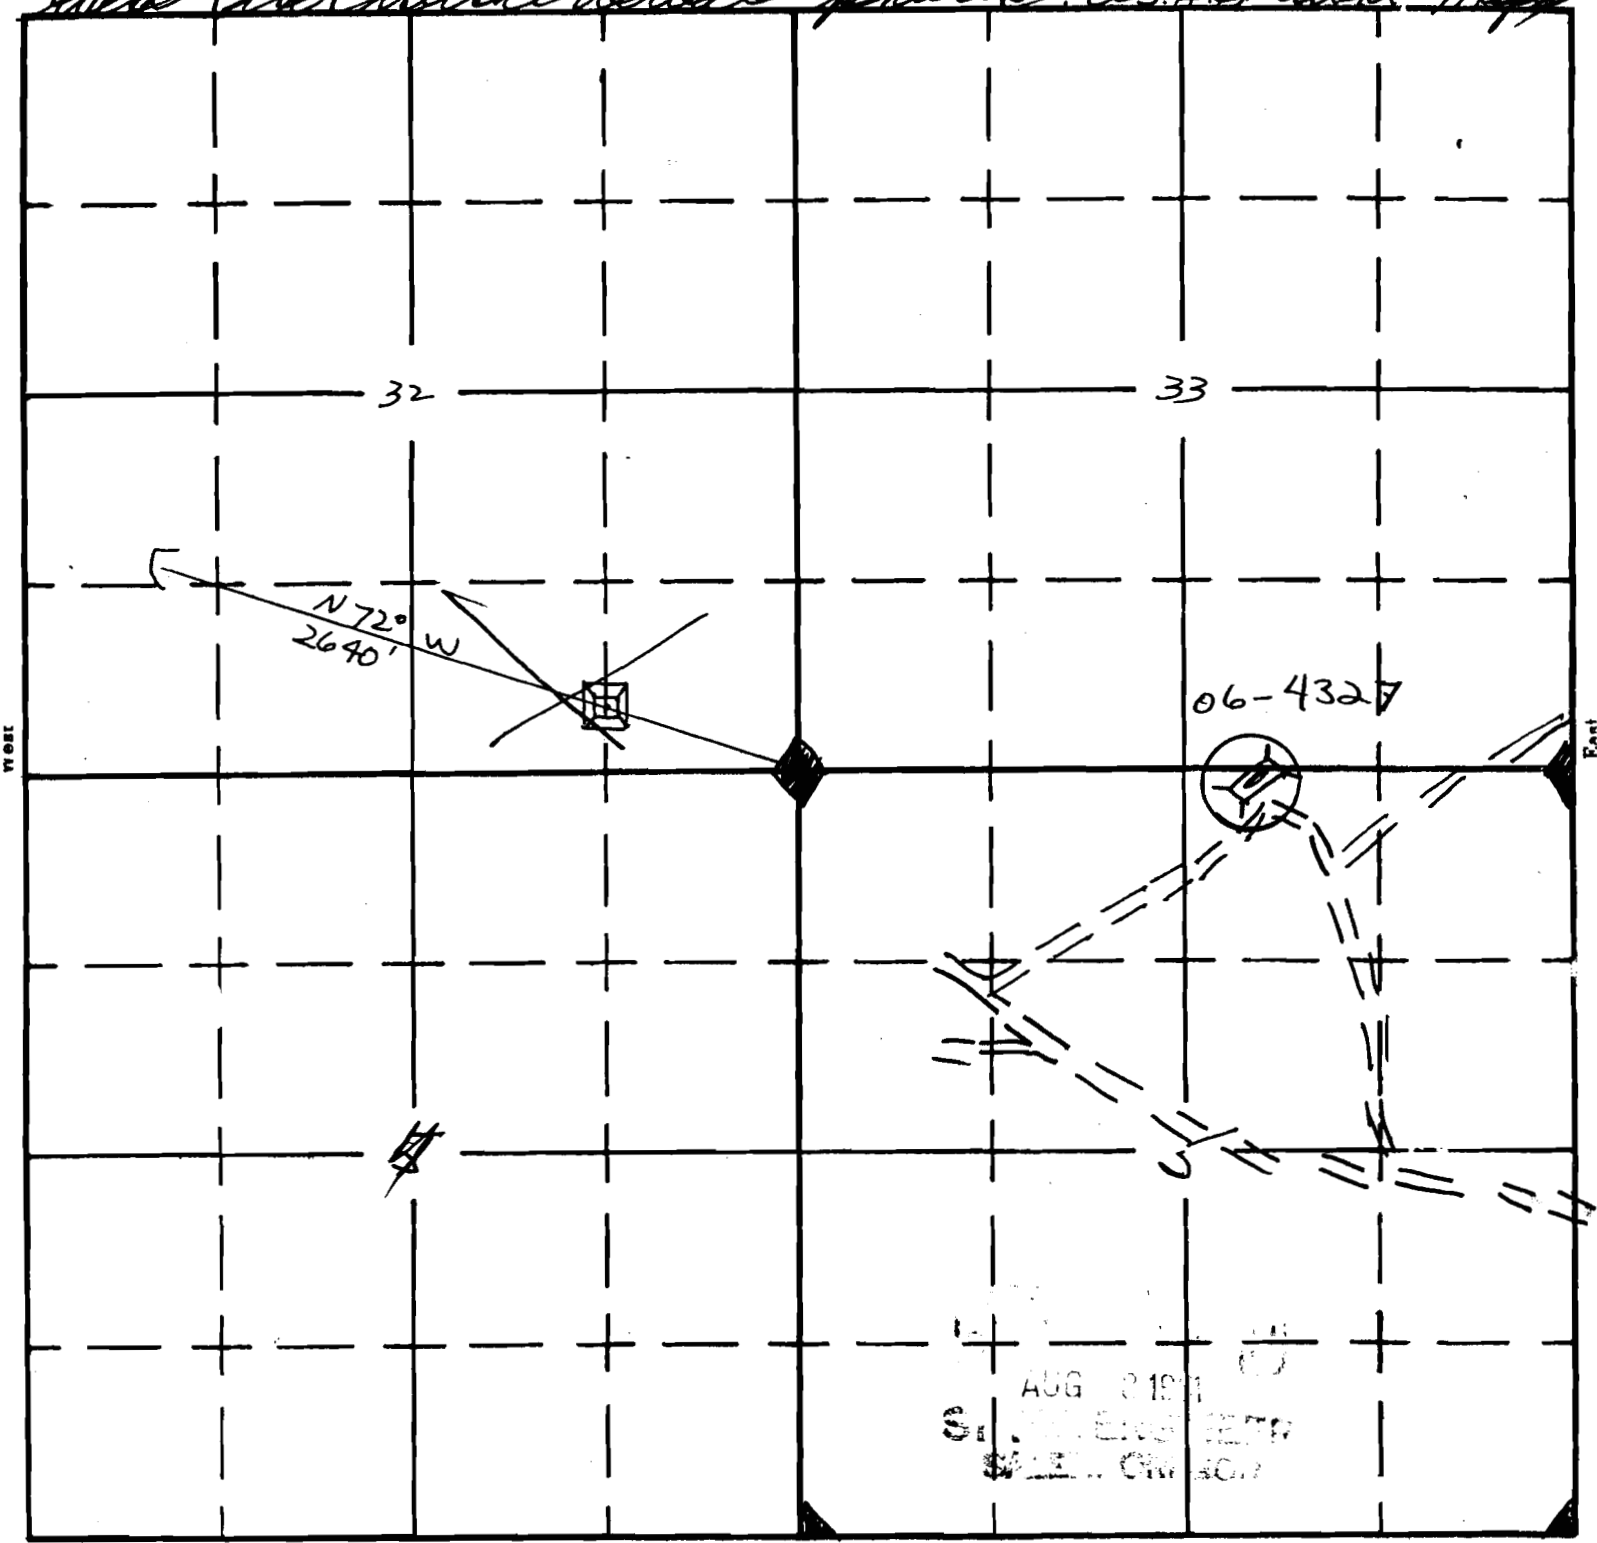

South

APPLICATION No. *R-36375*
PERMIT No. *R-4097*