


T. 29 S., R. 12 W., W.M.

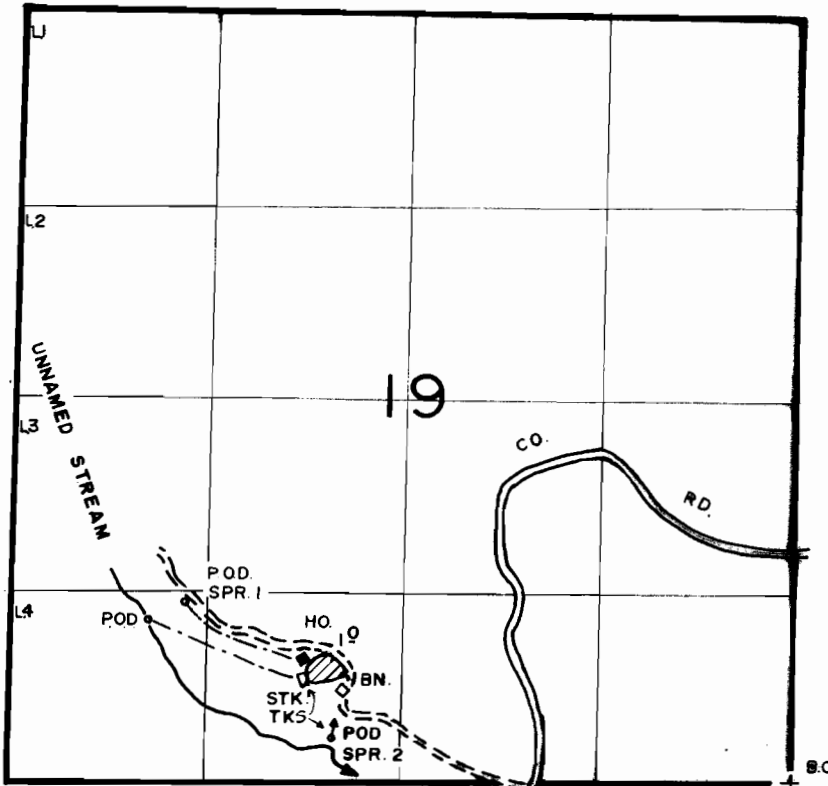

1" = 1320'

CREEK P.O.D. LOCATED 1120' N. & 4380' W FROM SE CORNER SEC. 19  
 SPR. 1 LOCATED 1240' N. & 4130' W FROM SE CORNER SEC. 19  
 SPR. 2 LOCATED 310' N. & 3130' W FROM SE CORNER SEC. 19

**FINAL PROOF SURVEY**  
 UNDER

Application No. <sup>62751</sup> 62752 Permit No. <sup>46892</sup> 46972

IN NAME OF  
 ERVIN A. ROYER

Surveyed JUNE 19 90 by B.S. JAMES

8-1-90 DSM  
 41011-180-225L