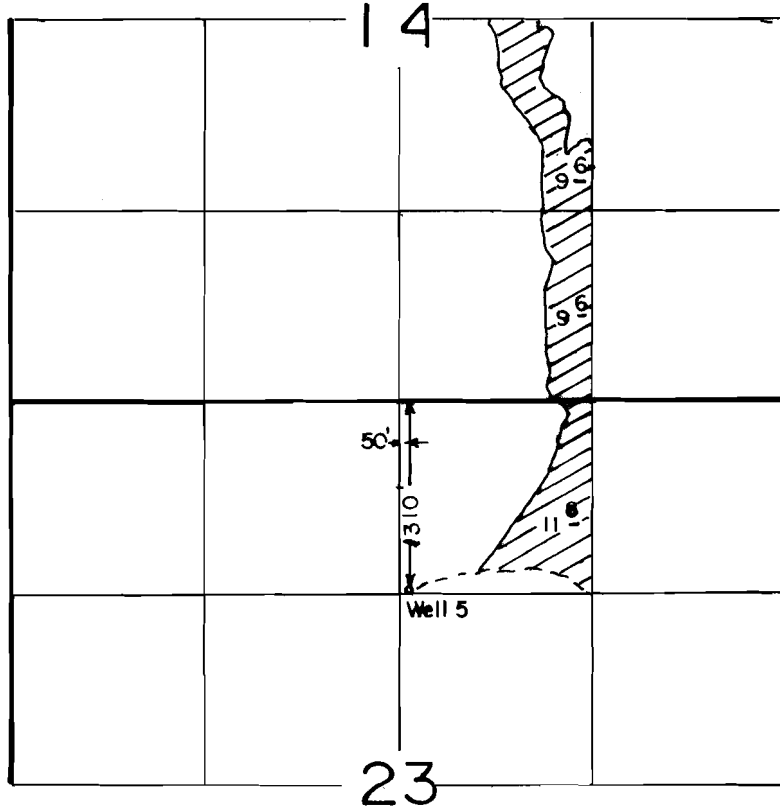


T. 39 S, R. 35 E, W.M.



SCALE: 1" = 1320'

**FINAL PROOF SURVEY
UNDER**

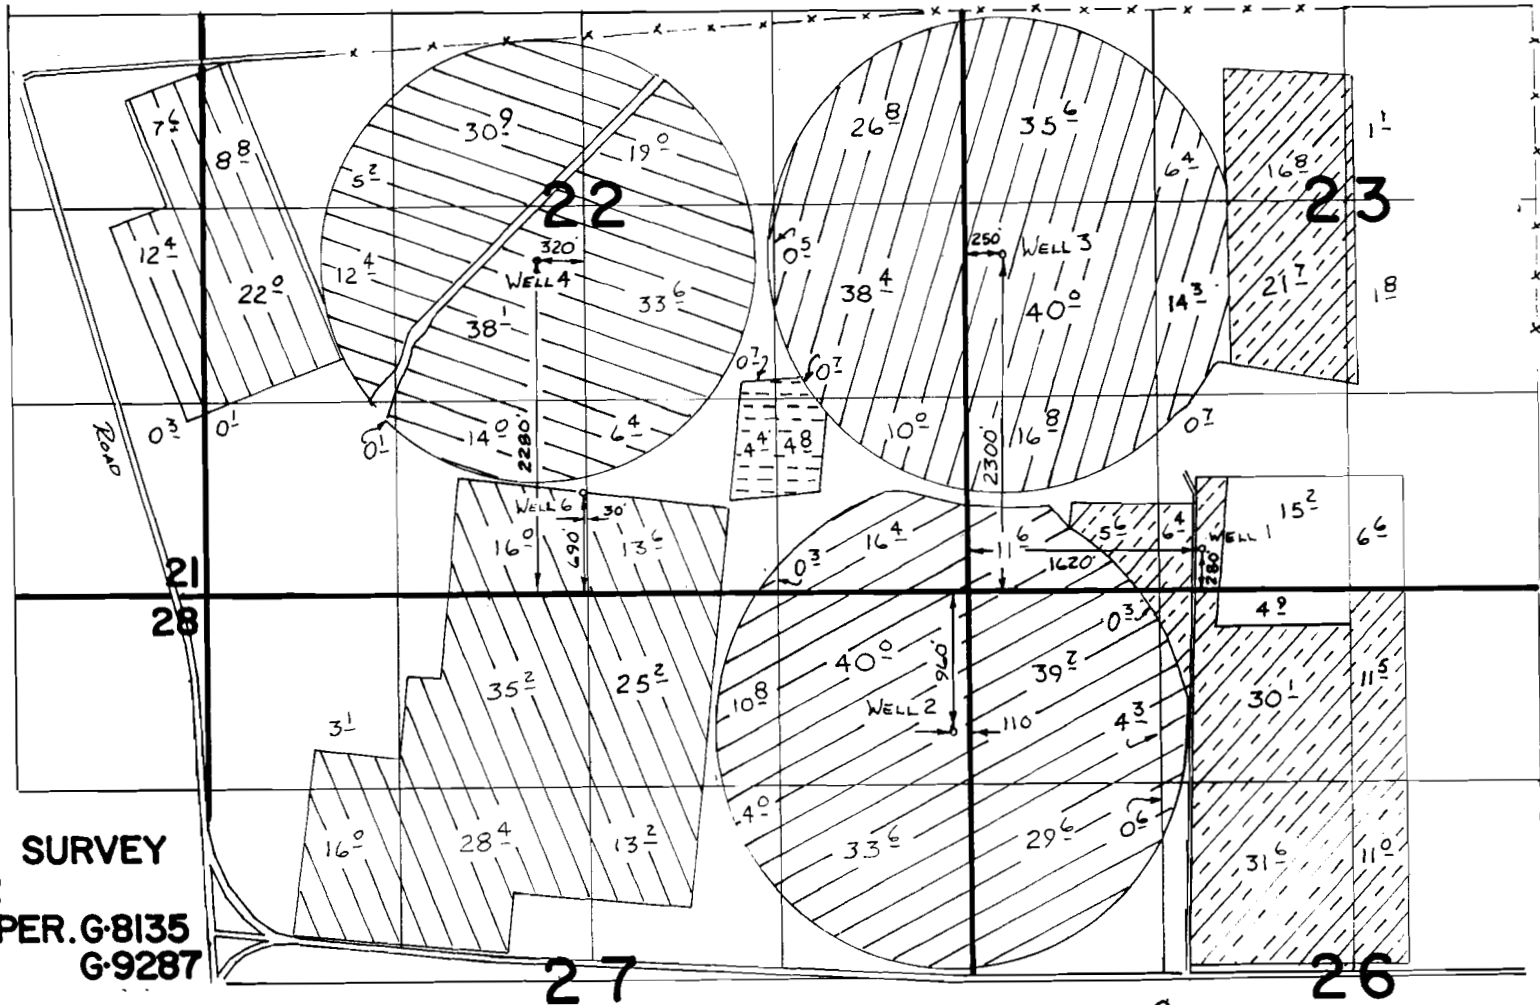
Application No. G-8586.. Permit No. G-8135.....
IN NAME OF

.....LORIN.....SHERBURN.....

Surveyed JULY 16, 1988..., by V.L. CHURCH.....

T. 39S., R. 35E., W. M.


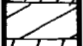


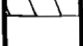

Scale 1" = 1320'



FINAL PROOF SURVEY
 UNDER
 APPL. G-8586 PER. G-8135
 G-10227 G-9287

IN NAME OF

WALLY COLEMAN

-  WELL #1 PRIM
 -  WELL #2 PRIM.
 -  WELL #3 PRIM.
 -  WELL #4 PRIM
 -  WELL #6 PRIM
- PER G-8135
-  WELL #6 PRIM. PER. 9287

COPY from
 G 10227