


# T. 38 S., R. 10 E., W.M.

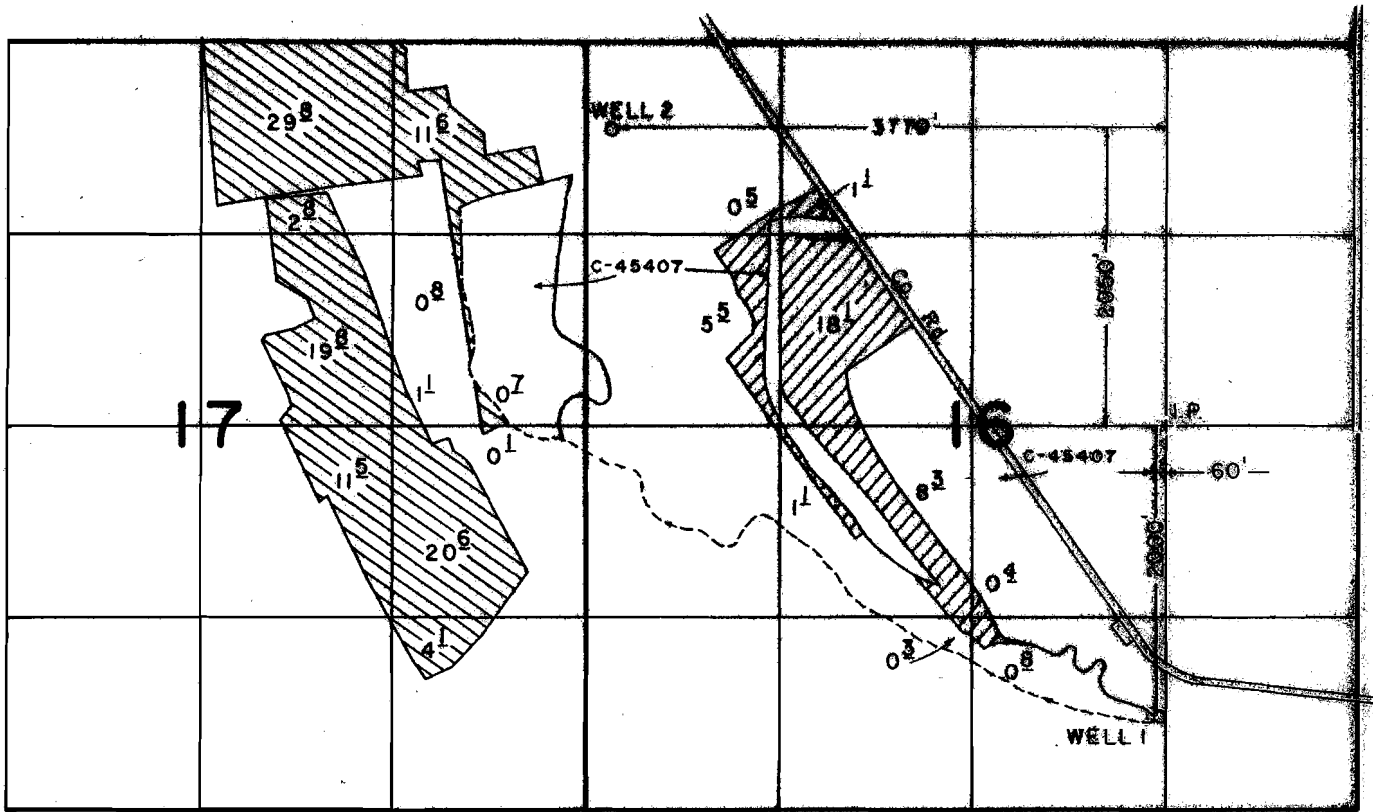

SCALE: 1" = 1320'

## FINAL PROOF SURVEY UNDER



Application No. G-11495 Permit No. G-10610...  
IN NAME OF

**MEADOW LAKE INC.**

Surveyed APRIL 11, 1990, by D.W. SPARKS.