


T. 34 & 35 S. R. 8 & 9 E. W.M.

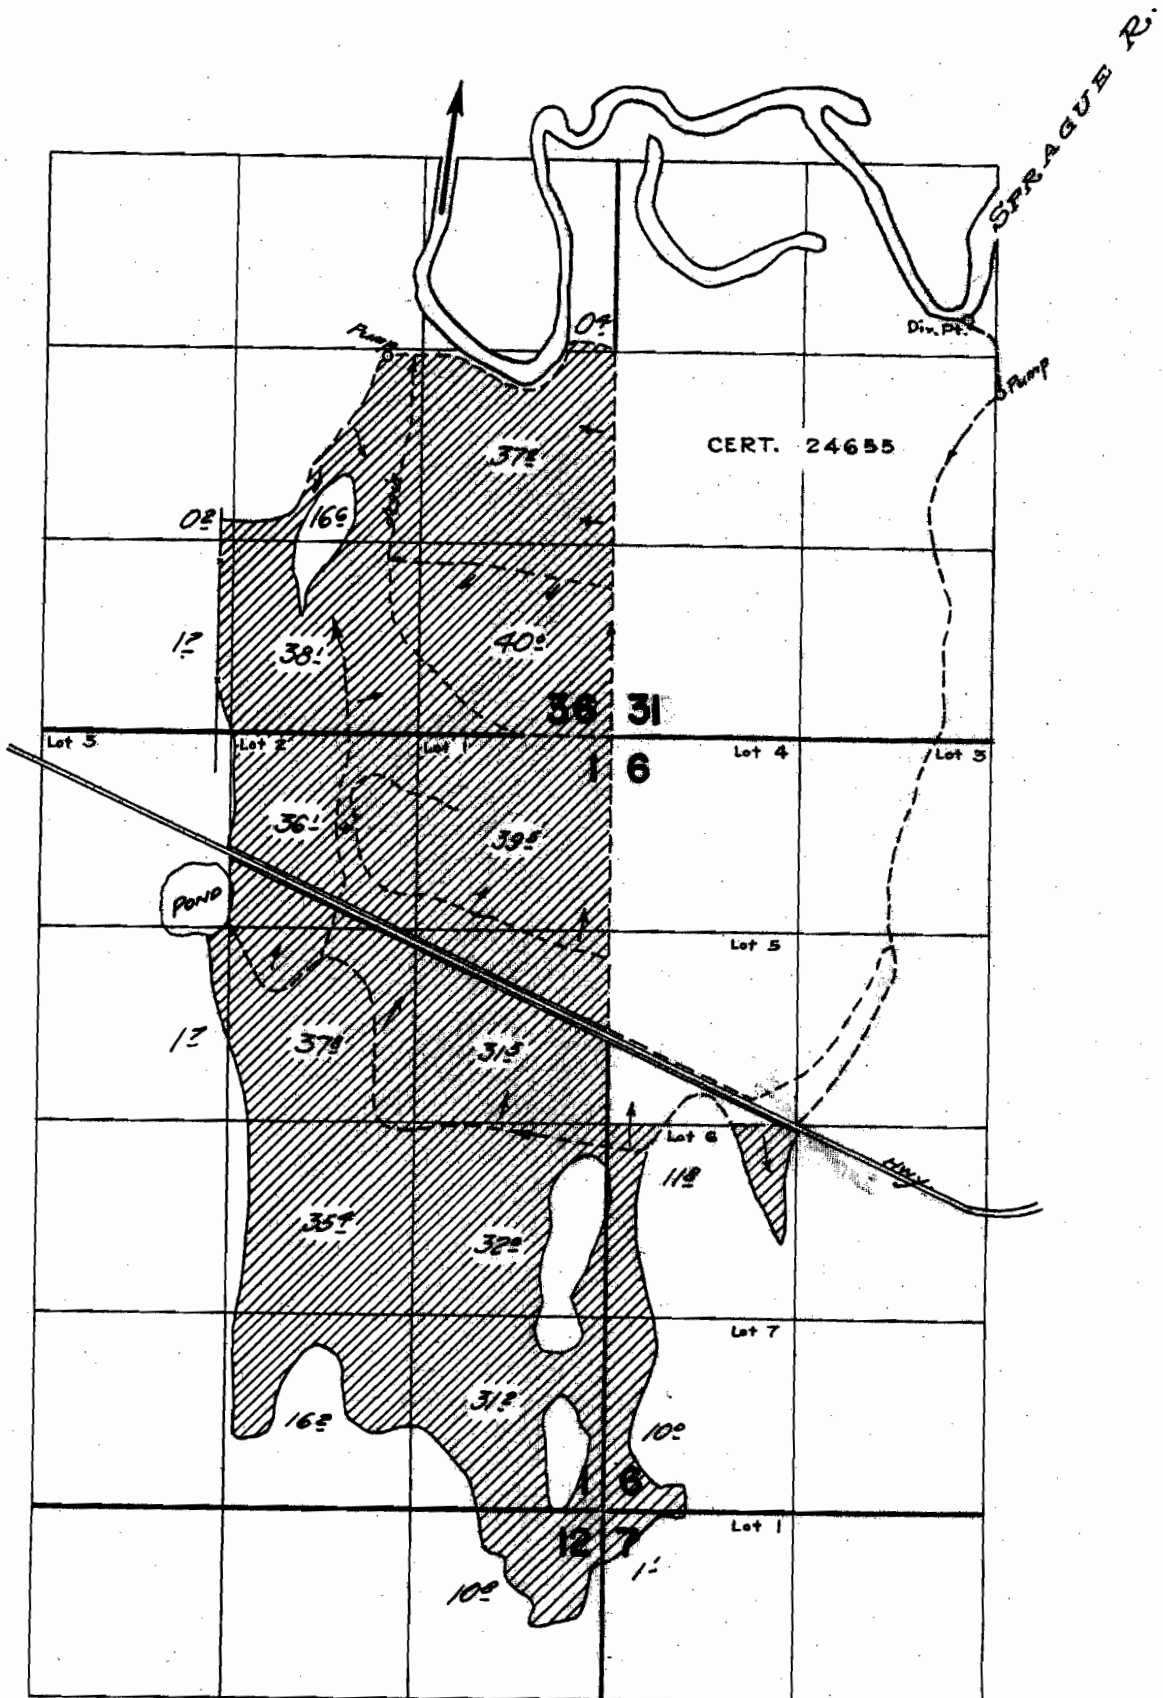

**FINAL PROOF SURVEY**  
UNDER

Application No. 31479 Permit No. 24816

IN NAME OF

Henry G., J.W. and Gerald C. Wolff

Surveyed June 10 1961 by R. H. Jackson