


T. 111., R. 38E., W.M.

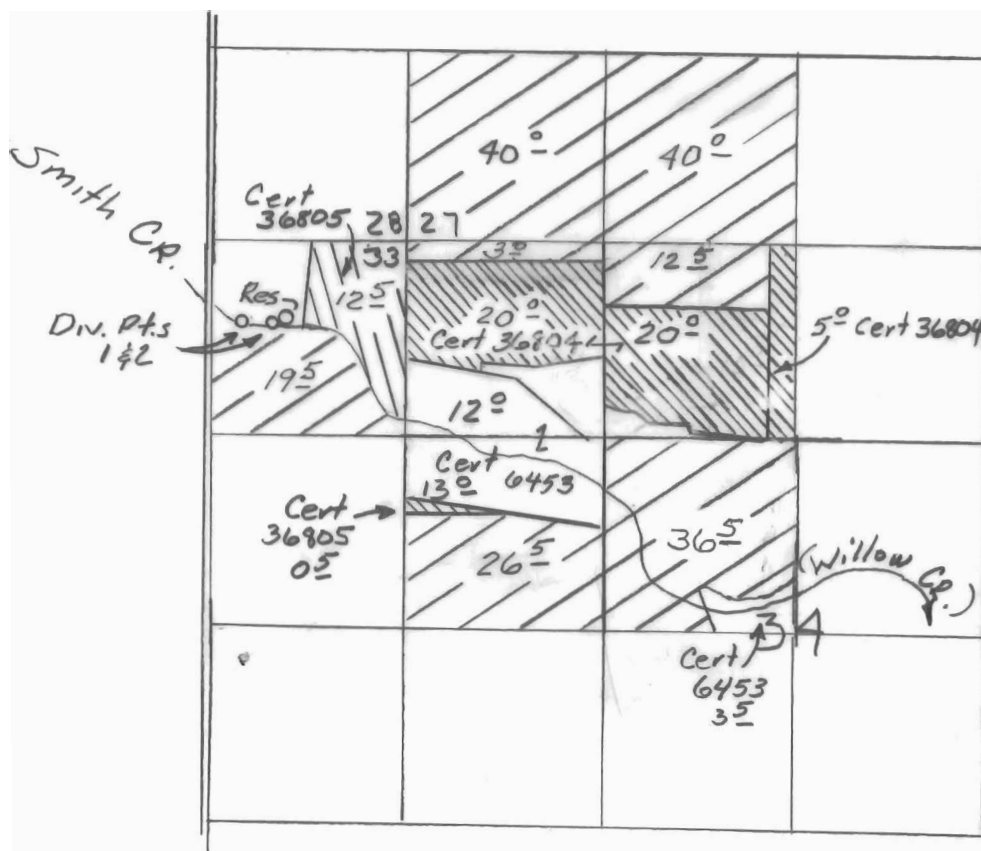

DIV. PTS LOC.: No. 1- 550 feet South and 1150 feet West; No. 2- 550 feet South and 930 feet West; Reservoir - 550 feet South and 830 feet West; all from the NE Corner of Section 33

FINAL PROOF SURVEY

UNDER

R-61291

R-8473

61281

46910

Application No. Permit No.

IN NAME OF

Spencer & Davis

Surveyed 9 July 1993, by J. Miller

41061-179-243L

deb