


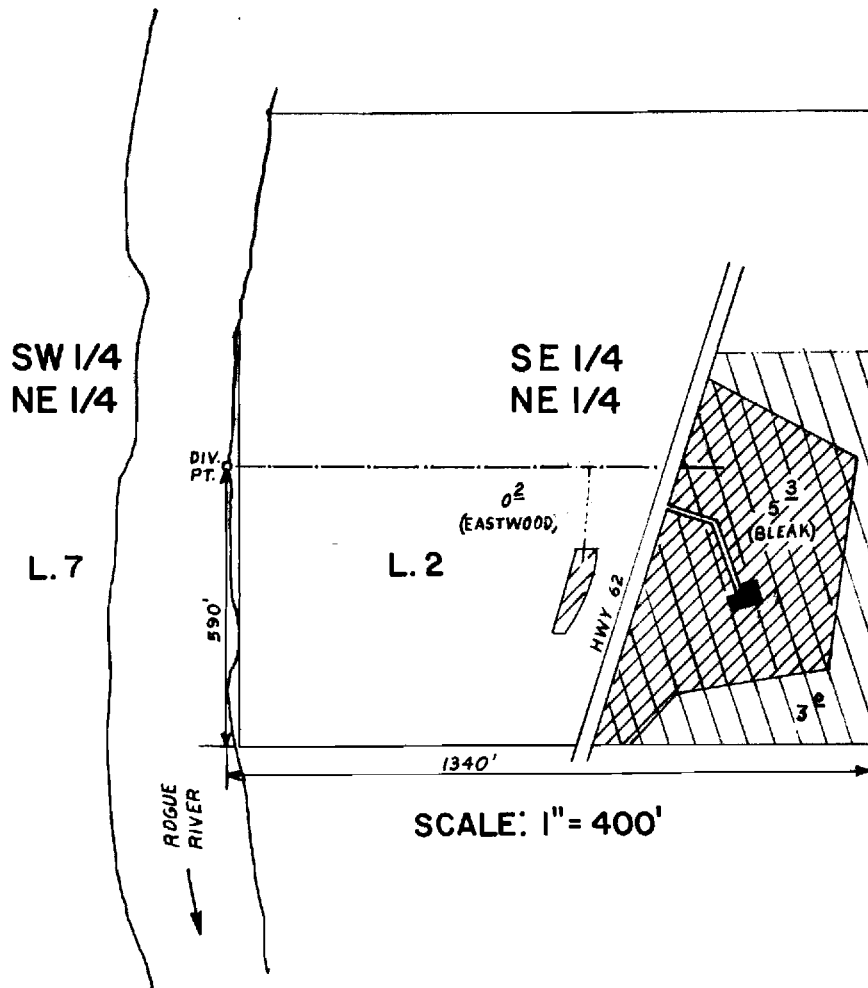


T. 34 S., R. 1 W., W.M.
 SEC. 21



-  permit PRIMARY 41179
-  Primary 48276 & Supplemental
-  Supplemental 48276

FINAL PROOF SURVEY
 UNDER

67438 48276
 Application No. 52564 Permit No. 41179
 IN NAME OF

GENE BLEAK and WAYNE W. & ELIZABETH A. EASTWOOD

Surveyed JUNE 24 19 83, by B. S. JAMES