


# FINAL PROOF MAP HALE BROTHERS FARMS TRANSFER T-8507 INVOLVING PERMITS G-434 AND G-1227

RECEIVED  
JAN 10 2005  
WATER RESOURCES DEPT  
SALEM, OREGON

### WELL LOCATIONS


AMMON #2  
LOCATED 100' S AND 130' W FROM E1/4 COR, SEC 2, T2N R27E W.M.  
HANSON #1  
LOCATED 10' S AND 10' E FROM NW CORNER SEC 12, T2N R27E W.M.  
HALE SR.  
LOCATED 1040' S AND 440' W FROM NE CORNER, SEC 7, T2N R28E W.M.

- PERMIT # G-434 PRIMARY IRRIGATION  
POA AMMON #2, HANSON #1 & HALE SR
- PERMIT # G-434 SUPPLEMENTAL IRRIGATION  
POA AMMON #2, HANSON #1 & HALE SR
- PERMIT # G-1227 PRIMARY IRRIGATION  
POA AMMON #2, HANSON #1 & HALE SR
- PERMIT # G-1227 SUPPLEMENTAL IRRIGATION  
POA AMMON #2, HANSON #1 & HALE SR

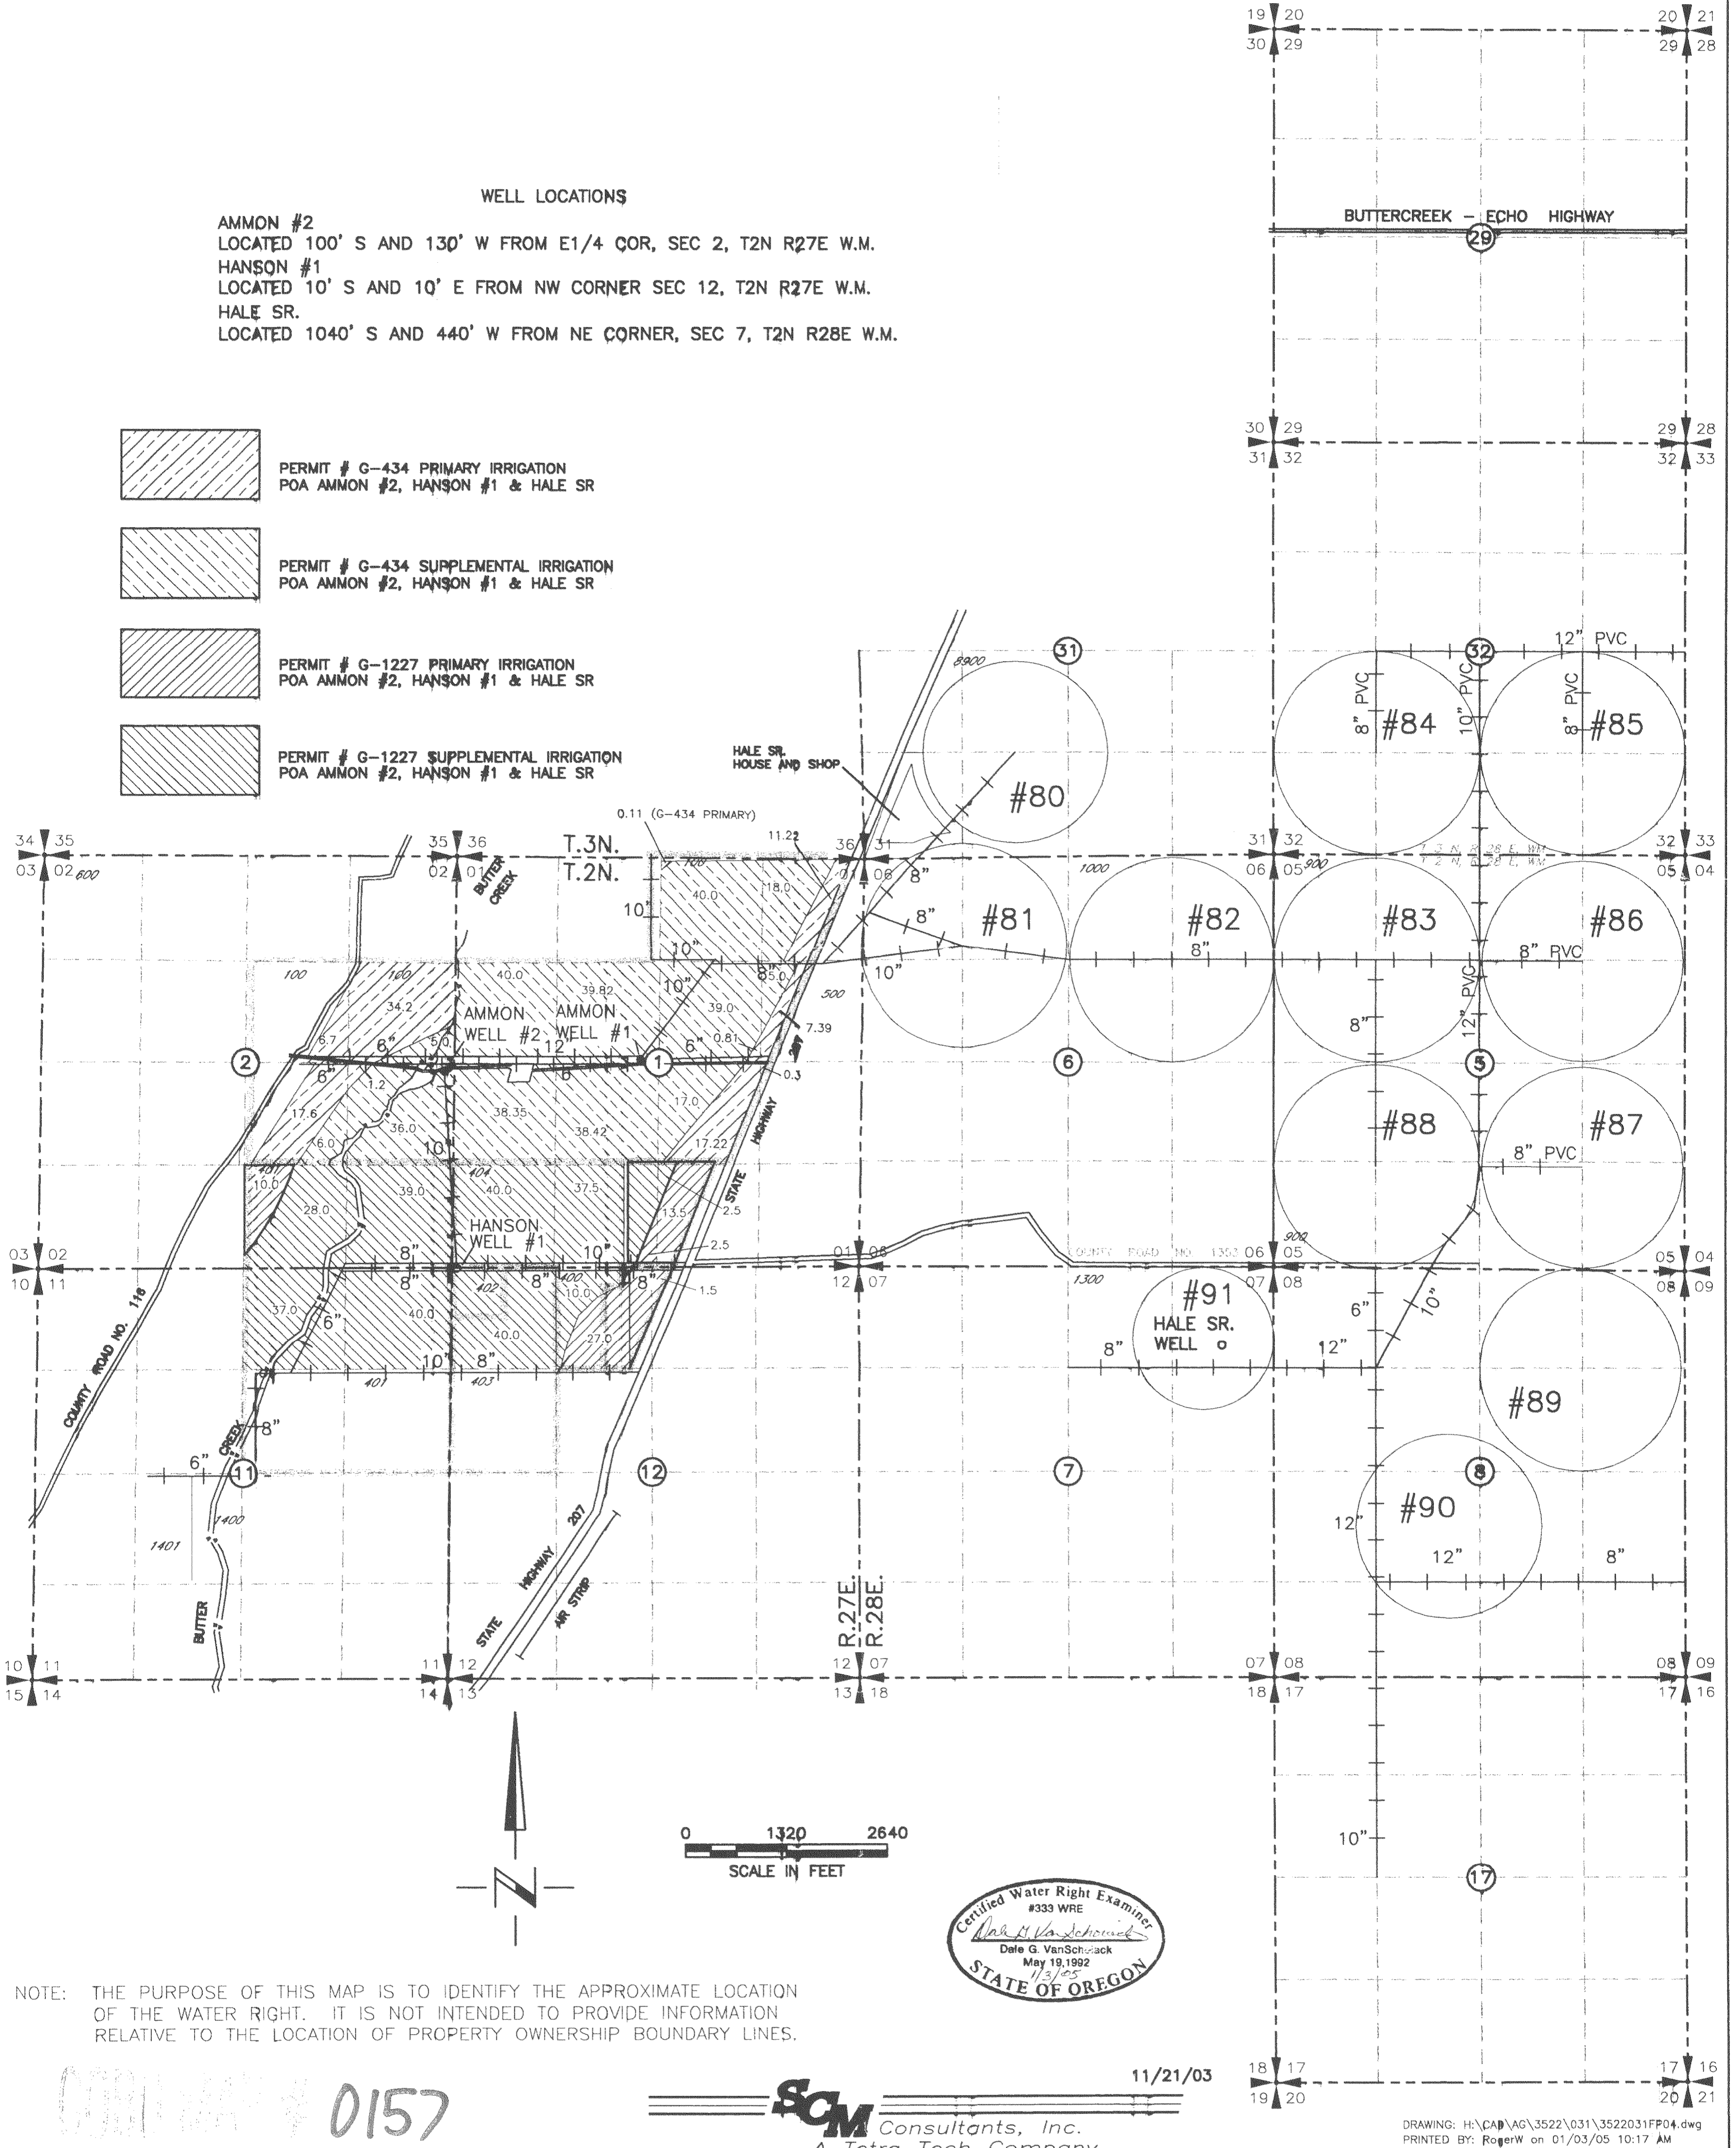

NOTE: THE PURPOSE OF THIS MAP IS TO IDENTIFY THE APPROXIMATE LOCATION OF THE WATER RIGHT. IT IS NOT INTENDED TO PROVIDE INFORMATION RELATIVE TO THE LOCATION OF PROPERTY OWNERSHIP BOUNDARY LINES.

0157

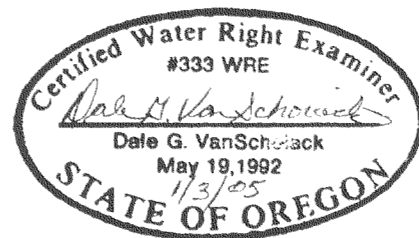

11/21/03