


SE 1/4 SECTION 13, T29S, R5W, WM

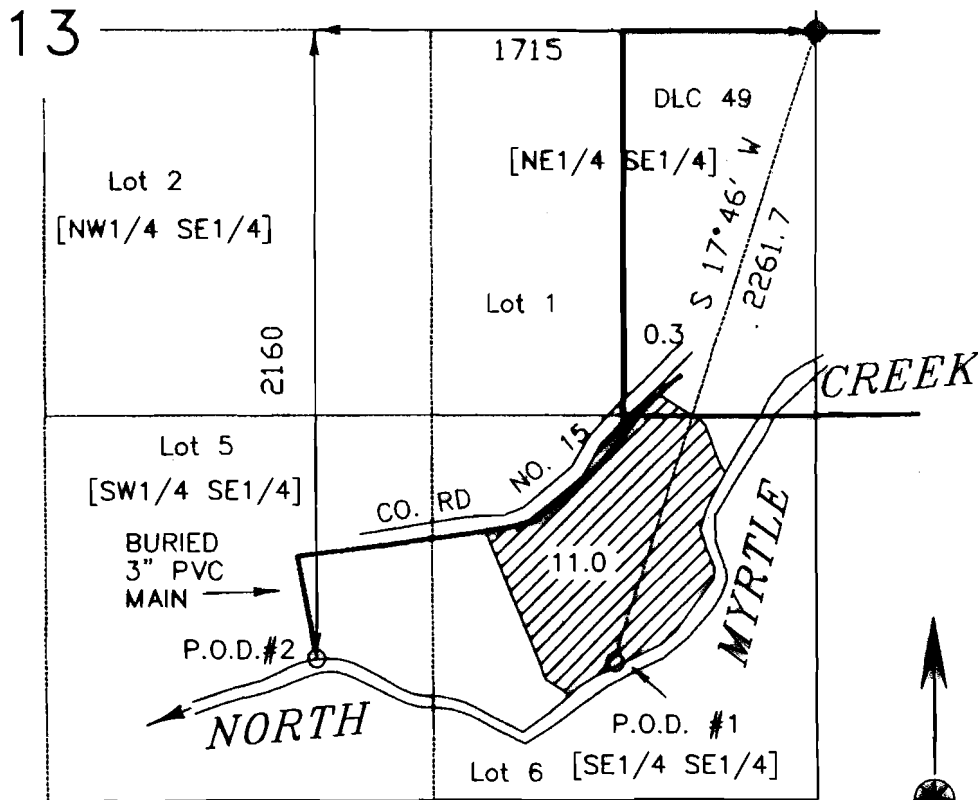

SCALE 8"=1MILE

0 330 660 1320

SCALE

SURVEY BASED ON
SURVEY FOR PERMIT
24813 FOR E.V. WEAVER


ASSESSOR PAGE 29 05 13
TAX LOT 200

THIS MAP IS TO BE USED FOR WATER RIGHT PURPOSES ONLY

MAP TO ACCOMPANY CLAIM OF BENEFICIAL USE FOR WATER RIGHT TRANSFER T-8055

IN NAME OF

Stanley E. and Margo L. Tenold

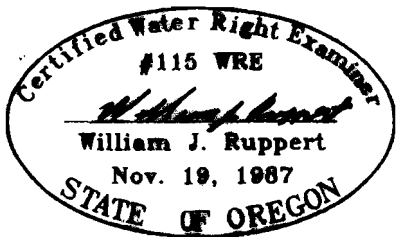

BY:
WILLIAM J. RUPPERT
P.O. BOX 1564
MYRTLE CREEK, OR 97457

NOV. 21, 2004

RECEIVED

JAN 28 2005

WATER REOURCES DEPT
SALEM, OREGON