


T. 1S. R. 2W., W.M.

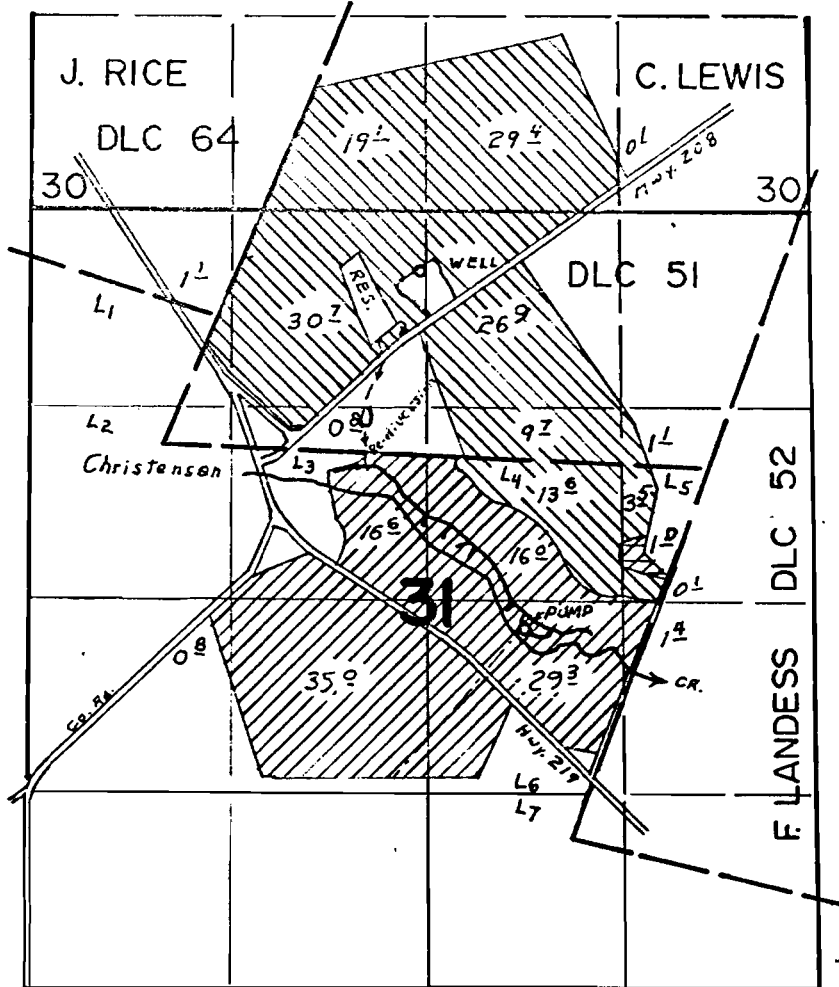

Well: 420's f 2650', Reservoir: 850's f 2350'E. Re-diversion: 1750's f 2290'E, Pump: 2850's f 3360'E all from NW corner Section 31

Permits R-6128 & 37849 (supplemental) { Permit G-5692 Primary
 Permit - G-5692 Supplemental

FINAL PROOF SURVEY UNDER

G-5800 G-5692
 R-53059 R-6128
 Application No. 53060 Permit No. 37849
 IN NAME OF

OREGON BERRY PACKING CO.

Surveyed JUNE 21, 22, 1978, by S. R. APPLGATE

SECTION 31, T.15., R.2W., W.M.
WASHINGTON COUNTY, OREGON

30 29
31 32

CERTIFICATE WELL LOCATION
420' S, 2650' E N.W. COR SEC. 31
(TRANSFER FROM)
PHOTO LOCATION OF WELL

RECEIVED

001 11 1993

RESOURCES DEPT.
OREGON



SCALE: 1" = 400'
MAP BASE: CERT MAP S1795, ASSESSORS MAP
SCALED PHOTO

11.8 Ac.

SOUTH LINE CHARLES LEWIS
D.L.C. No. 51

S.E. CORNER
CHARLES LEWIS
D.L.C. No. 51

STATE
LOT 2



LOT 4

LOT 5



17.4 Ac

LOT 6

0.8 Ac.
T.L. 1700

S.W. CORNER
FELIX LANDERS
D.L.C. No. 52

WATER RIGHT TRANSFER MAP



PREPARATION OF THIS MAP IS FOR THE
PURPOSE OF IDENTIFYING THE LOCATION OF
THE WATER RIGHT ONLY. THERE IS NO INTENT
TO PROVIDE DIMENSIONS OR LOCATION OF
PROPERTY OWNERSHIP LINES.

WELL LOCATION 380' S. &
380' W. FROM S.W. COR. D.L.C. 52
(TRANSFER TO)

1/4 COR

31
6

VERBOORT ENGINEERING
AGRICULTURE • CIVIL • WATER RESOURCES
HILLSBORO, OREGON
T 7050

	by	date
designed	WRV	4.13.93
drawn	JER	4.13.93
checked	WRV	4.13.93
drawing no.	93-B-08	
sheet no.	1/1	

MALENSKY LAND HOLDING CO
11335 SW, HILLSBORO HIGHWAY
HILLSBORO, OR 97123