


T. 1S. R. 2W., W.M.

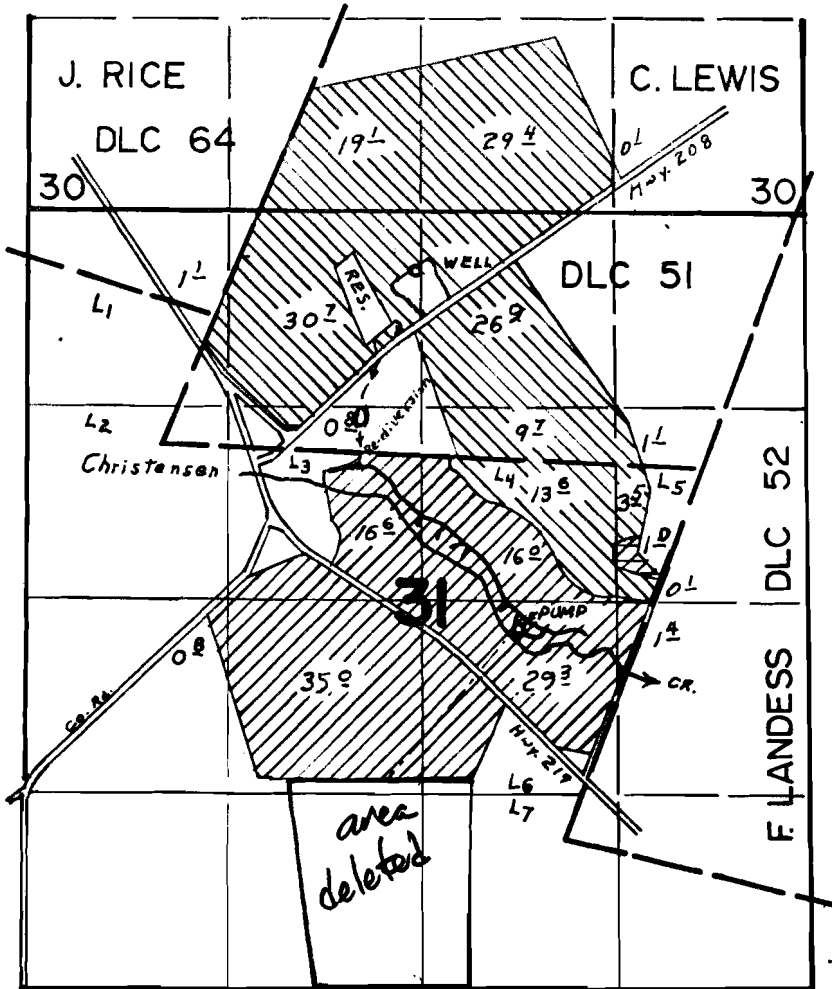

Well: 420'S x 2650', Reservoir: 880'S x 2350'E, Re-direction: 1750'S x 2290'E, Pump: 2850'S x 3360'E all from NW corner Section 31

Permits R-6128 & 37849 (supplemental) { Permit G-5692 Primary
 Permit - G-5692 Supplemental

FINAL PROOF SURVEY UNDER

G-5800 G-5692
 R-53059 R-6128
 Application No. 53060 Permit No. 37849
 IN NAME OF

OREGON BERRY PACKING CO.

Surveyed JUNE 21, 22, 1978, by S.P. APPLGATE