


SE 1/4 SECTION 13, T29S, R5W, WM

13

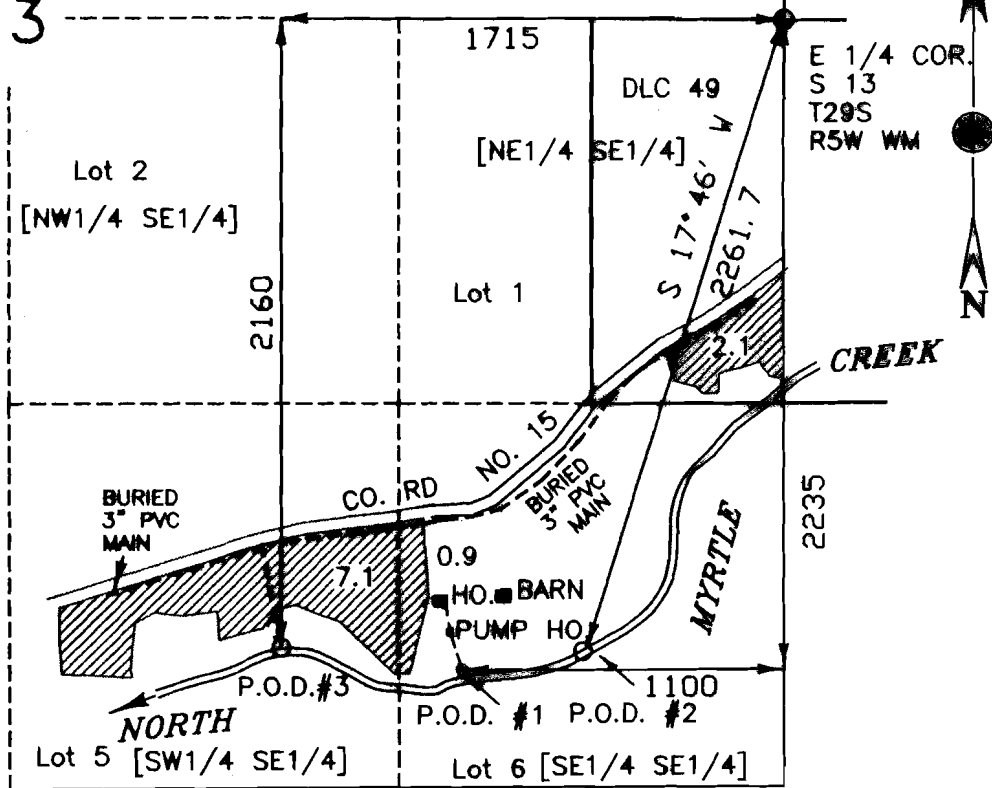

SCALE 8"=1MILE



BURIED PIPE: 1.5" PVC PIPE POD #1 TO PUMP
0.75" PVC PIPE FROM PUMP TO HOUSE

SURVEY BASED ON AERIAL PHOTO

THIS MAP IS TO BE USED FOR WATER RIGHT PURPOSES ONLY



MAP TO ACCOMPANY CLAIM OF BENEFICIAL USE FOR WATER PERMIT 47919, APPL. 65296

ASSESSOR PAGE 29 05 13
TAX LOT 200

IN NAME OF
Stanley E. Tenold



SCALE 4"=1MILE

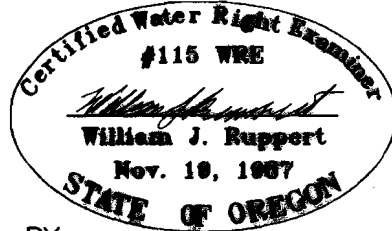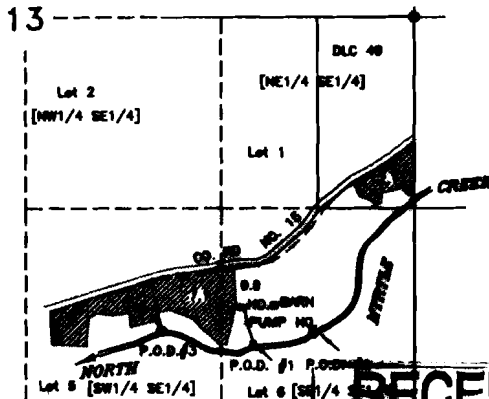

BY:
WILLIAM J. RUPPERT
P.O. BOX 1564
MYRTLE CREEK, OR 97457

RECEIVED

FEB. 5, 2005

FEB 24 2005

WATER RESOURCES DEPT
SALEM, OREGON