

MALHEUR NATIONAL FOREST

STOCK WATER


Antelope allotment
FS Temporary Id. # 83132
SCALE 4 IN. : 1 MILE

COPY

North

application no. 67492.

permit no. 50359

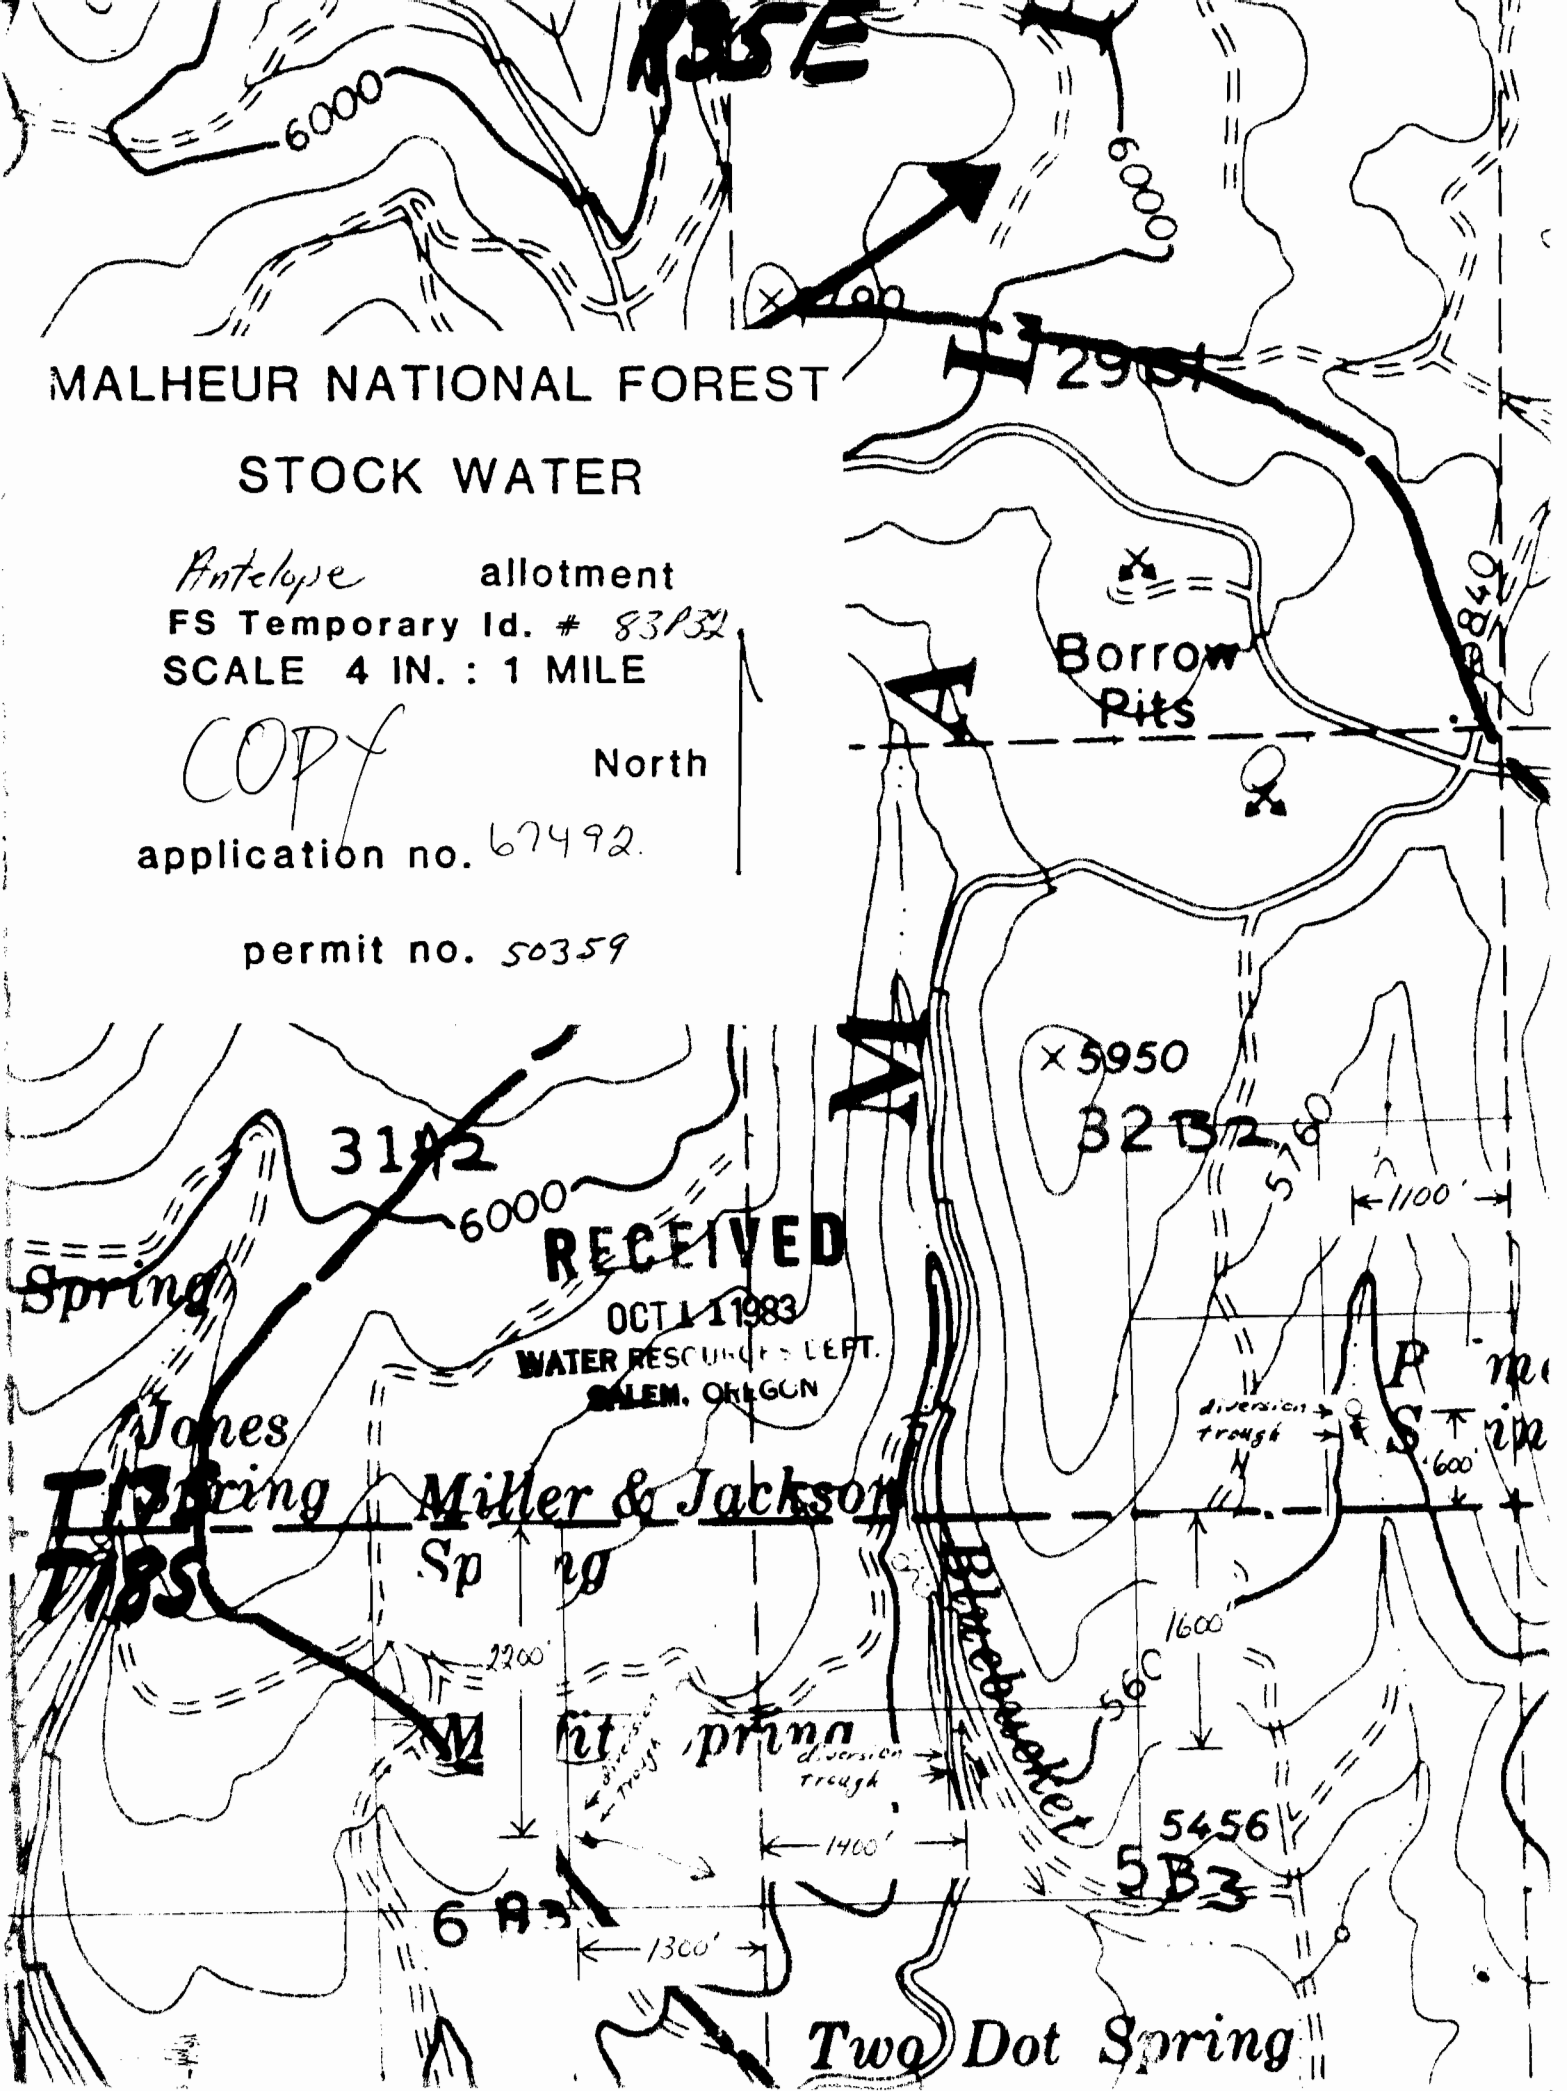

RECEIVED

OCT 11 1983

WATER RESOURCES LEFT
SALEM, OREGON

Two Dot Spring