

Map for S. B.

Form OR-010-7300-2
4/83

UNITED STATES
DEPARTMENT OF THE INTERIOR
BUREAU OF LAND MANAGEMENT

Section 4

SE NW

Township 28S

Range 25E


Appl. No. R67639

Permit No. R 9499

Will. Mer.

*is really
longer
than
shown
on this
map*

Robbin Reservoir 4239

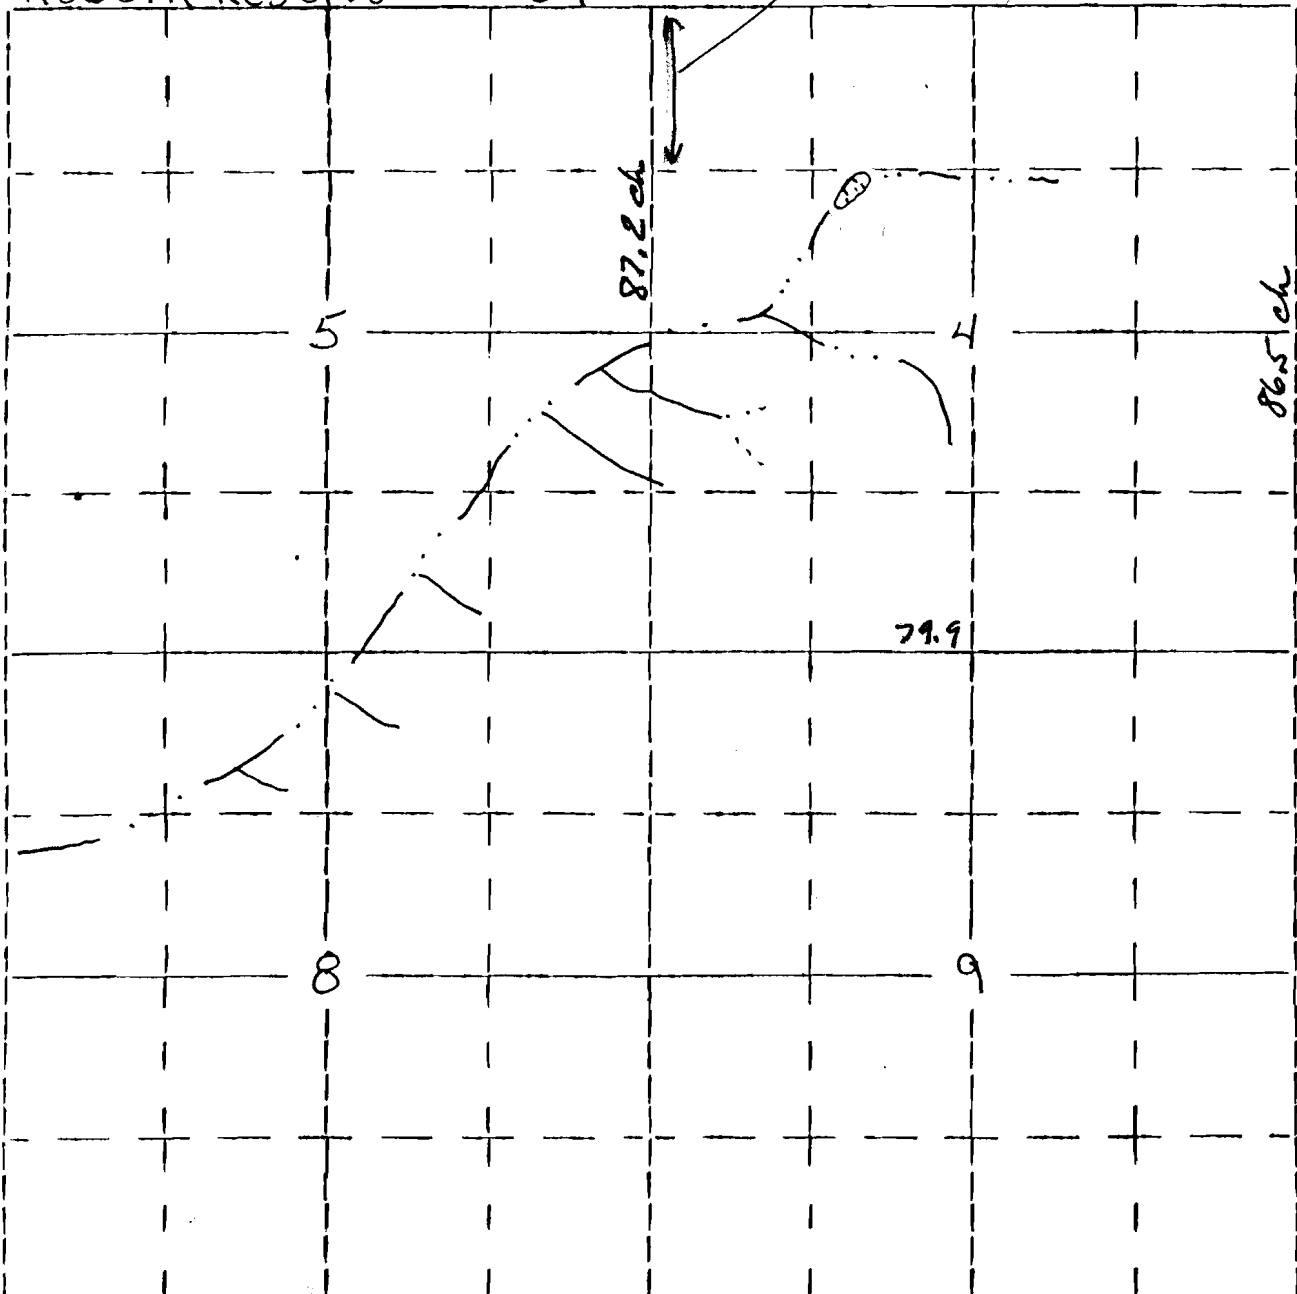

UNITED STATES
DEPARTMENT OF THE INTERIOR
BUREAU OF LAND MANAGEMENT


Section 4
SE NW

Township 28S
Range 25E

Appl. No. R67639
Permit No. R 9499

Will. Mer.

Robbin Reservoir 4239

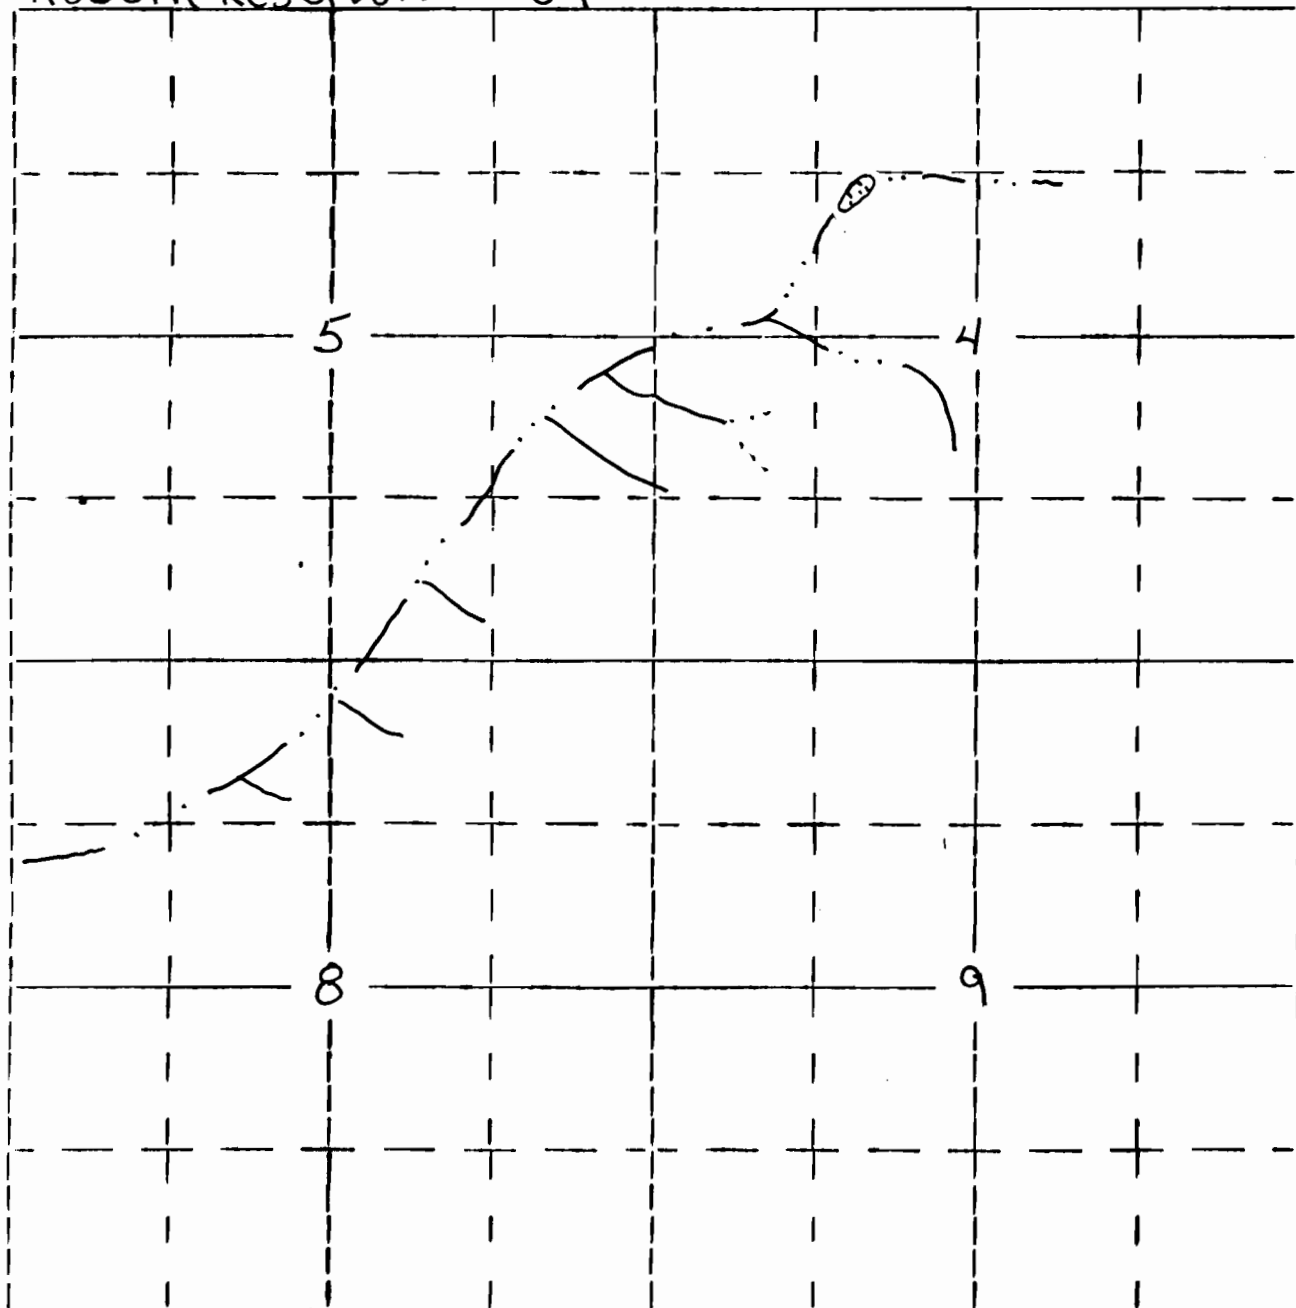

1400'S 1600'E of the NW corner of section 4