

4 A1-187
March 1961

UNITED STATES
DEPARTMENT OF THE INTERIOR
BUREAU OF LAND MANAGEMENT

SECTION

8


NE 1/4 SW 1/4

Oregon State Water Filings

TOWNSHIP 25S, RANGE 21E, W. M.

North

Tied in with aerial Photo and O.S.H.P.
Quad Maps.

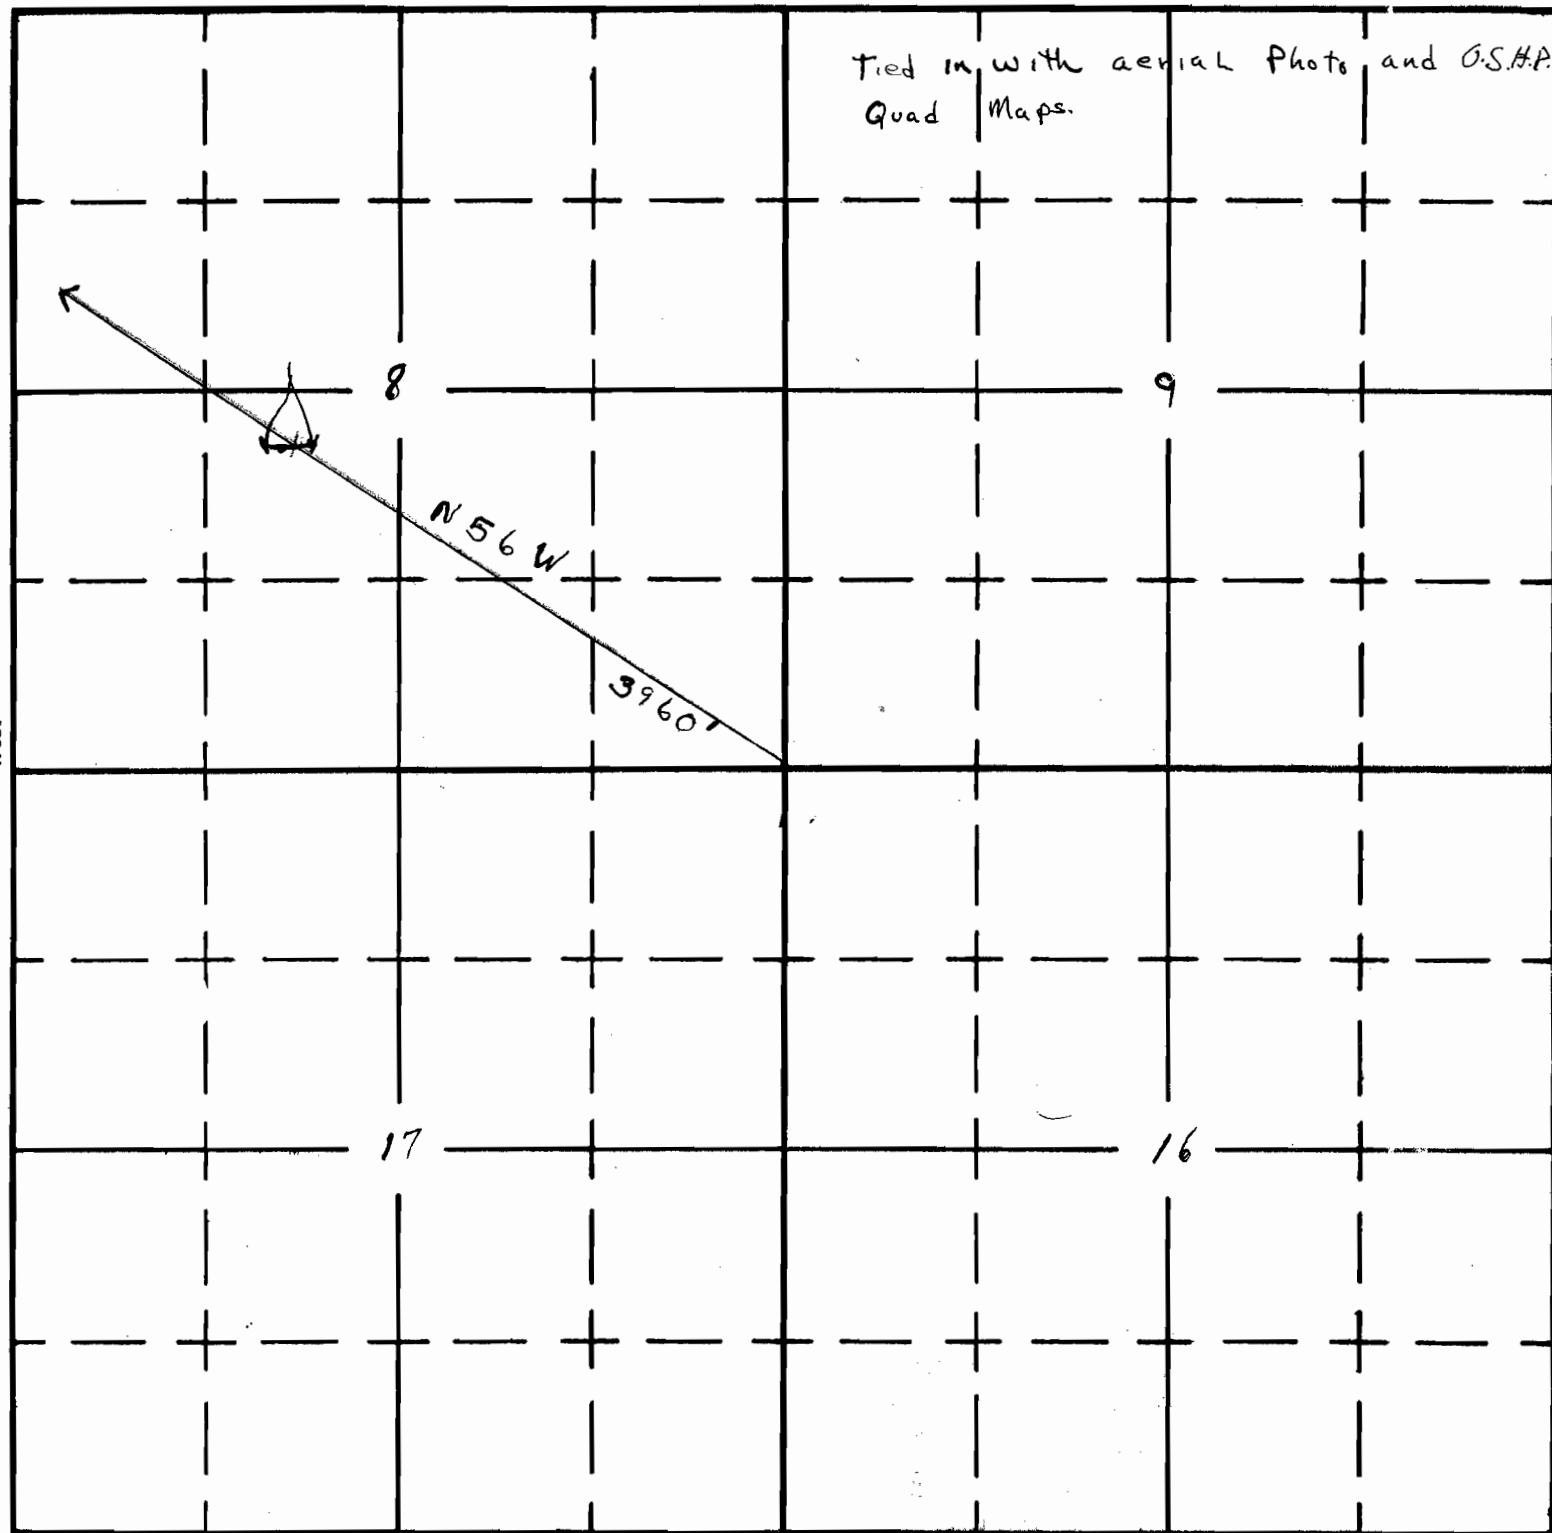

South

APPLICATION No. R-35131

PERMIT No. P-2846