

River


X-X: Location sketched from township maps.

2.
2 N., R. 11 E., W.M.

0.67-1924
D.M. - 1924

City Reservoir

0.4-1948

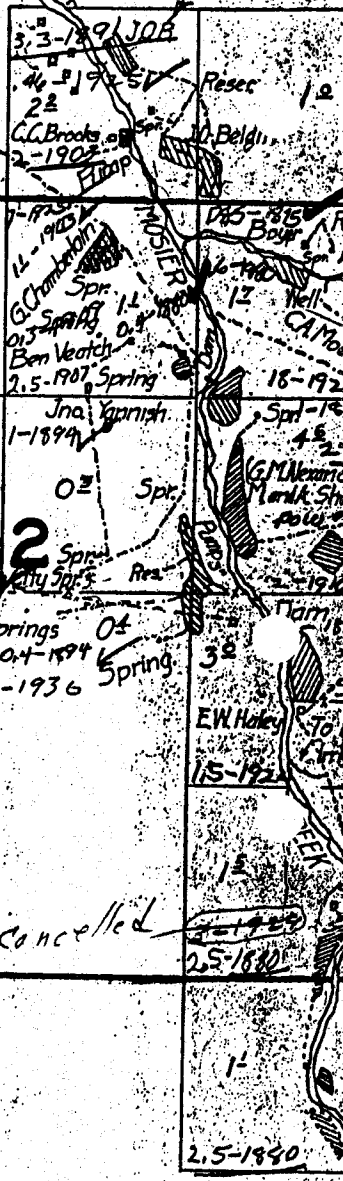

Lawyers Trust Co.
1510 Yeon Portland
J.E. Fulsome
T.I. Dobney
2.5
12
Spr.
Reser.
D.M. - 1908

Jna. Yarnish
1-1899
02
Spr.
Springs
04
0.4-1894
1-1936 Spring

11

14

13

Cancelled