

MALHEUR NATIONAL FOREST

STOCK WATER (XS)
 Sugarloaf allotment ^(map #2 of 3)

SCALE 4 IN. : 1 MILE

T155, R32+R33E North ↑


application no. 64395

permit no. 47865

RECEIVED

MAY 3 1 1983

WATER RESOURCES DEPT.
SALEM, OREGON

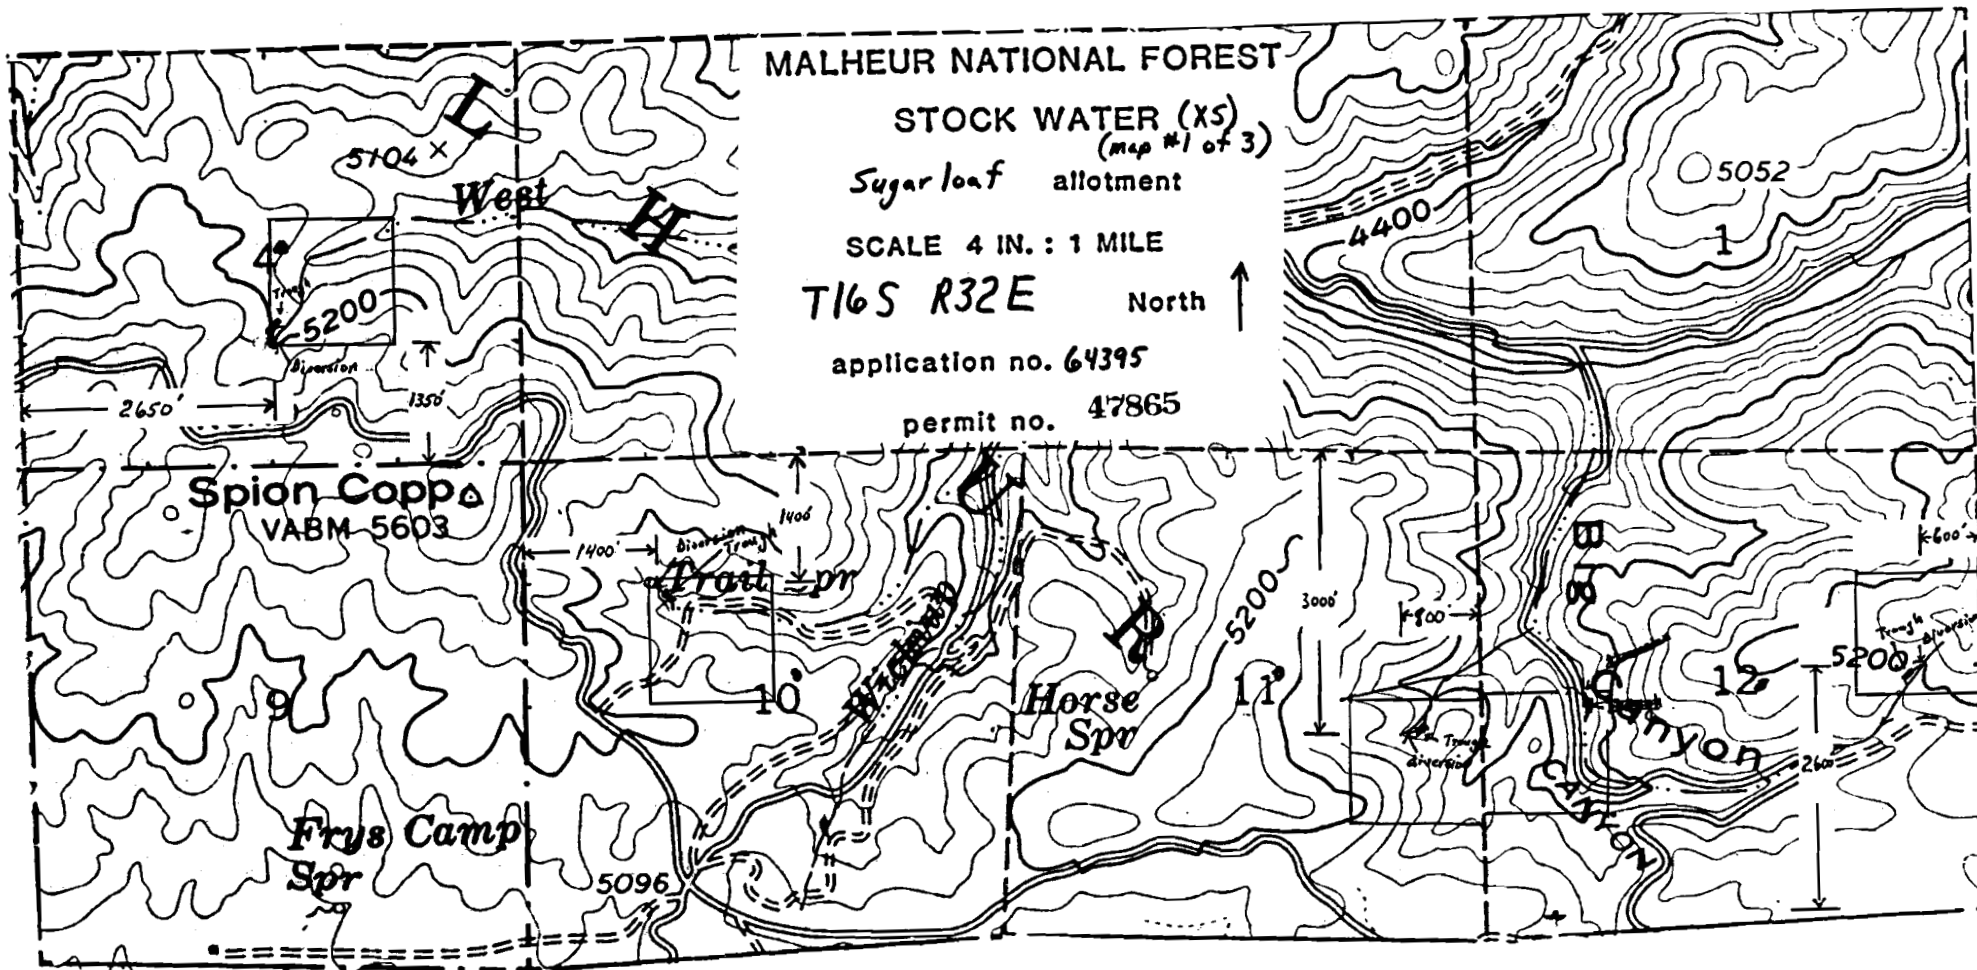

MALHEUR NATIONAL FOREST

STOCK WATER (X5)
(Map #3)

Sugarloaf allotment

SCALE 4 IN. : 1 MILE

T16S R33E North

application no. 64395

permit no. 47865

