


T. 2S, R. 3W, W. M.

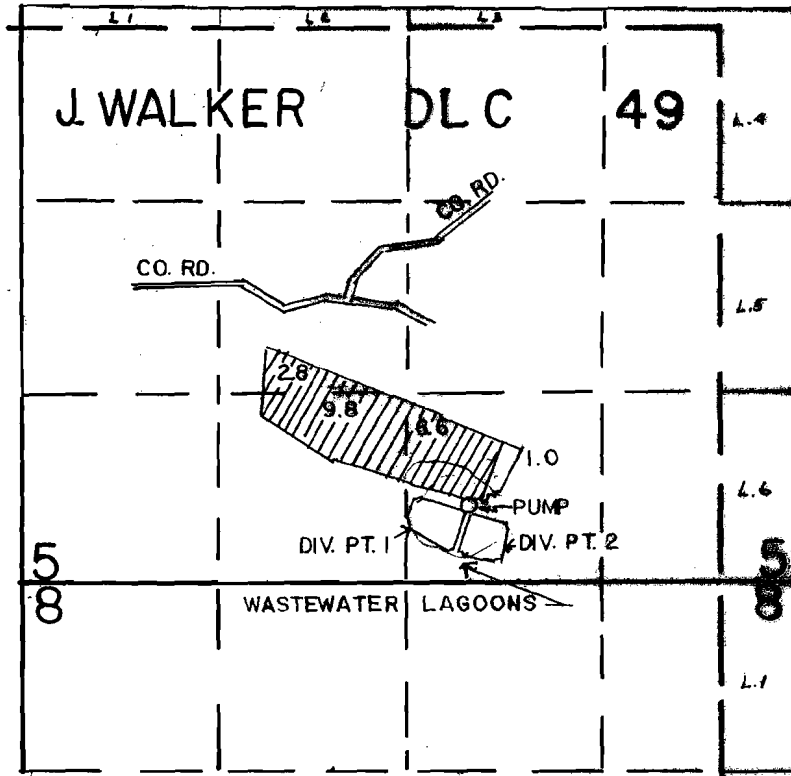

*DIV. PT. Located: 550 feet N. & 450 feet E.
from 5/4 Corner Section 5.*

SCALE: 4" = 1 MILE

*550' N
450' E*

FINAL PROOF SURVEY
UNDER

R-55228 R- 6574
Application No. 55229... Permit No. 41526.....
IN NAME OF

WESTERN OREGON CONFERENCE ASSOCIATION
OF SEVENTH-DAY ADVENTISTS
Surveyed NOV. 14... 19. 83, by L. TOLL.....