



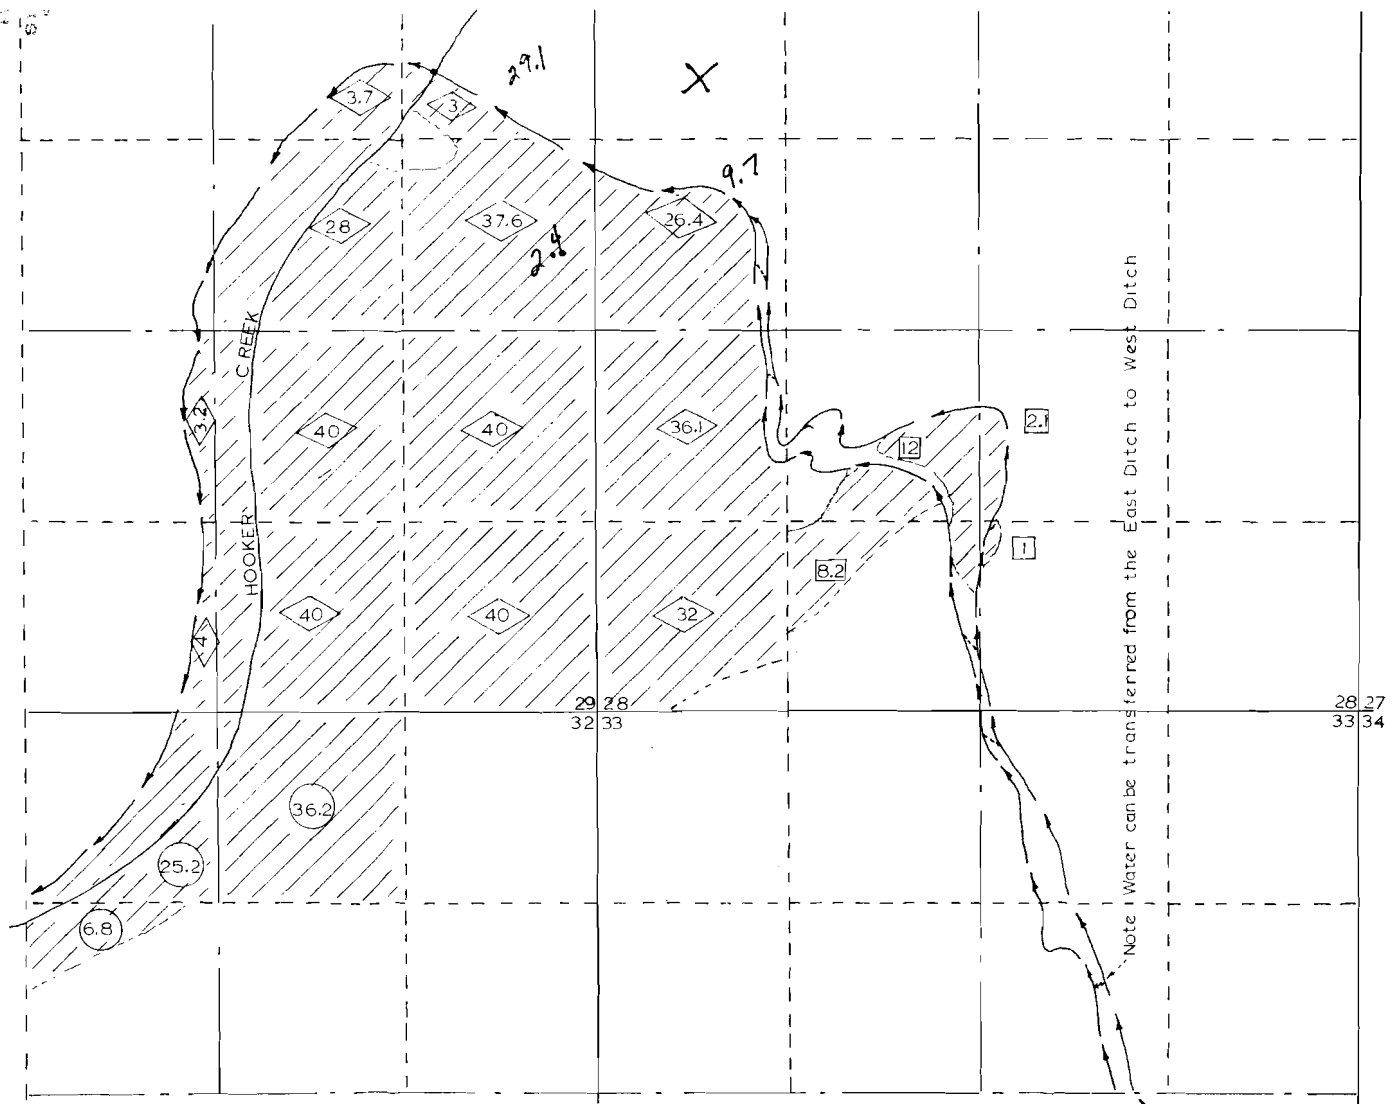


COPY

REGISTERED
PROFESSIONAL
LAND SURVEYOR
2014-15
W. E. GILBERT
3045

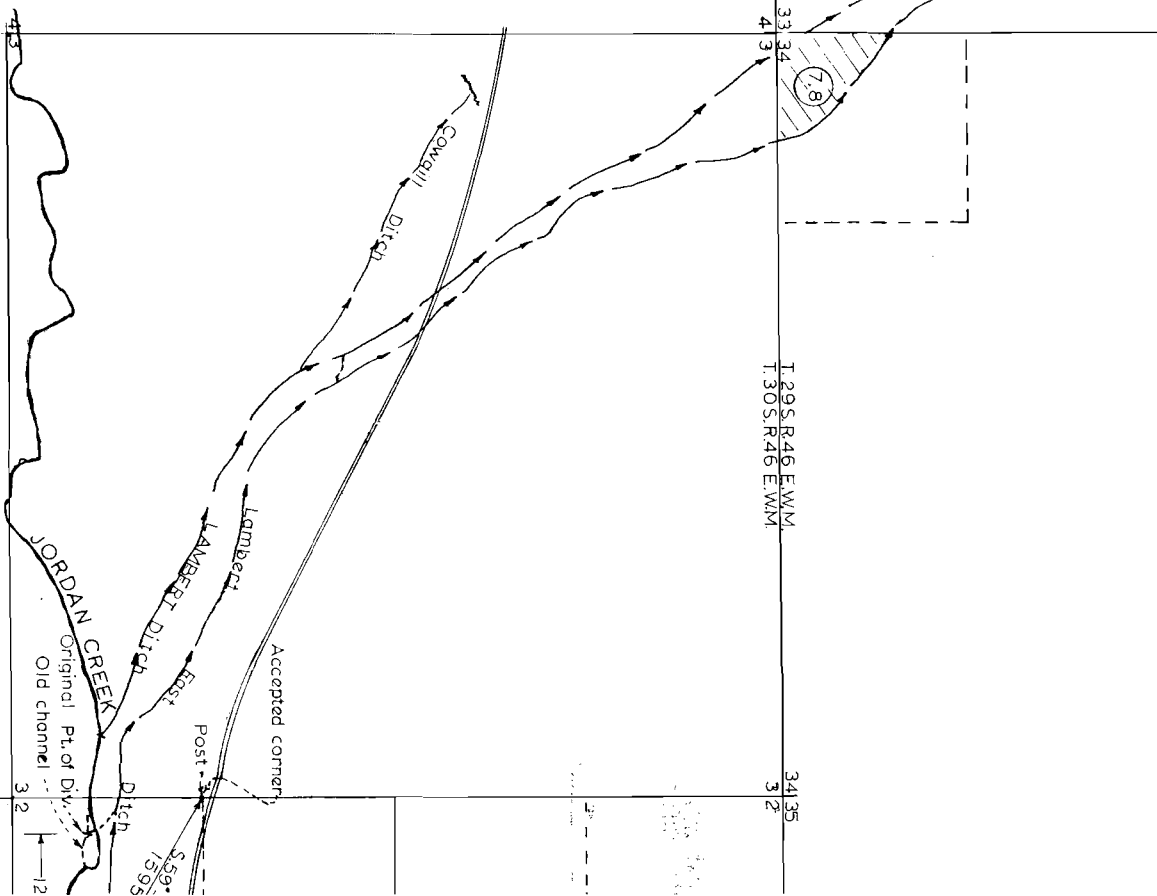

copy

30
T.29S., R. 46E., W.M.

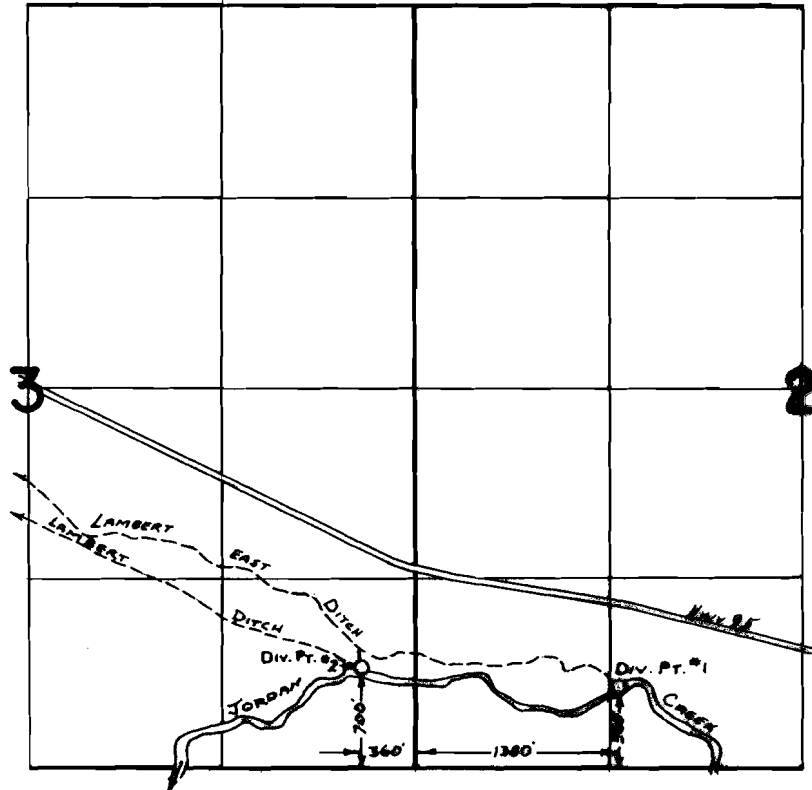

SCALE: 1" = 1320'

FINAL PROOF SURVEY UNDER

Transfer No. 2773
Application No. Permit No.
IN NAME OF

..... BILL & FLORENCE ROSS

Surveyed Oct. 18, 1985, by L. M. TOLL