
T.11S. R.10W. W.M.

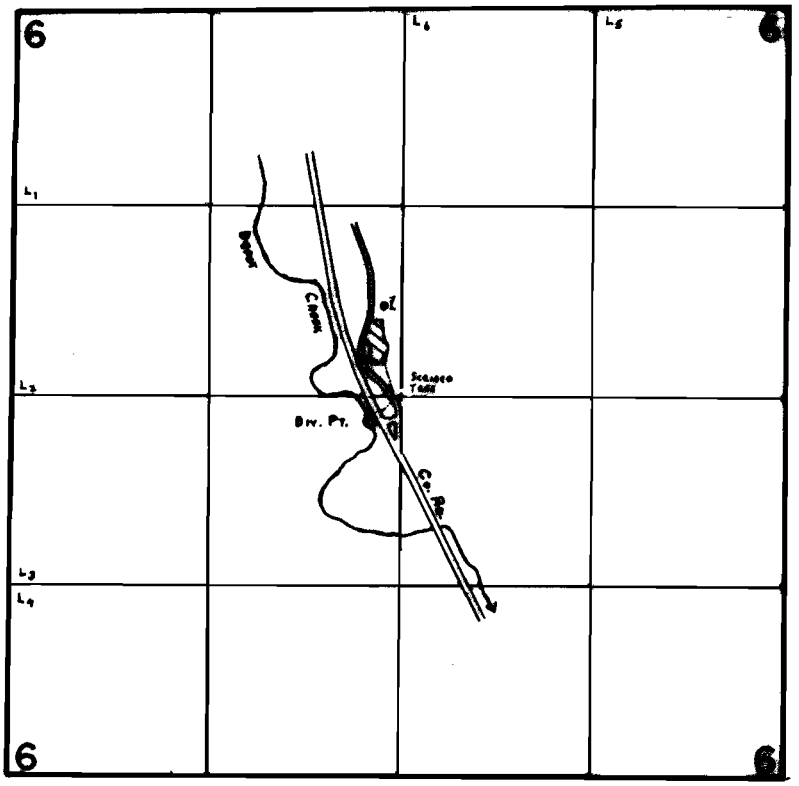

Div. Pt. Loc: 170'S. & 210'W. fr. C. ¼ Cor. Sec. 6.

FINAL PROOF SURVEY
UNDER

Application No. 49355 Permit No. 36999
IN NAME OF

MARY B. (BURGER) VANCE

Surveyed June 13 19 79, by C. L. HUGHES

4/64/ 272-2