COLLECTIONS A SPECIALTY

FIRE INSURANCE

CARL ROE

UNITED STATES COMMISSIONER


NOTARY PUBLIC

ENTERPRISE, OREGON

Tp. 2 N. R. 48 E. W. M

SCALE: 4 IN. TO 1 MILE

D. O. MAYNARD

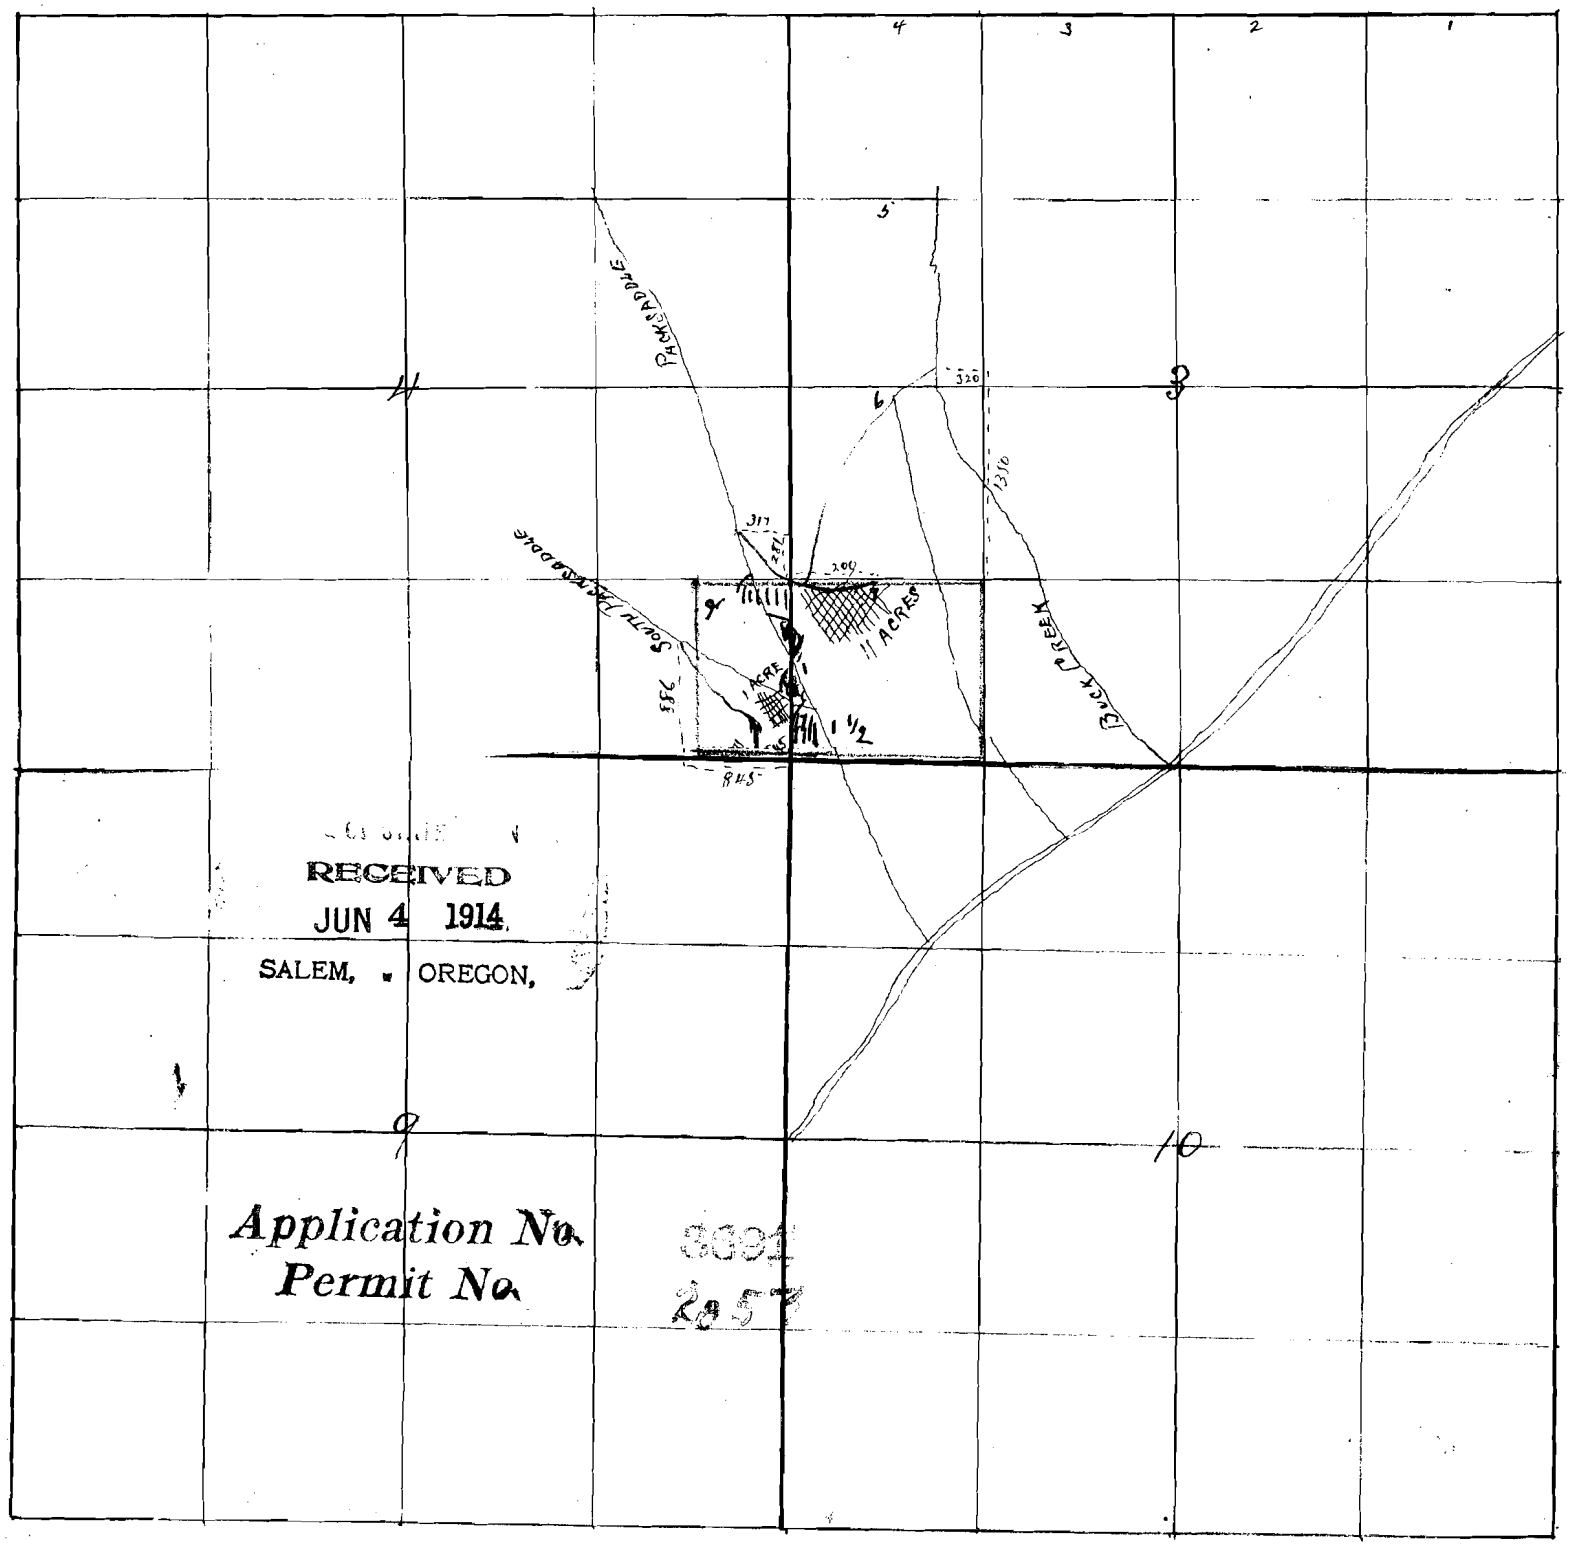


RECEIVED
JUN 4 1914
SALEM, OREGON,

Application No. 8334
Permit No. 2957