


SECTION

TOWNSHIP 9 S, RANGE 4 E, W. M.

North

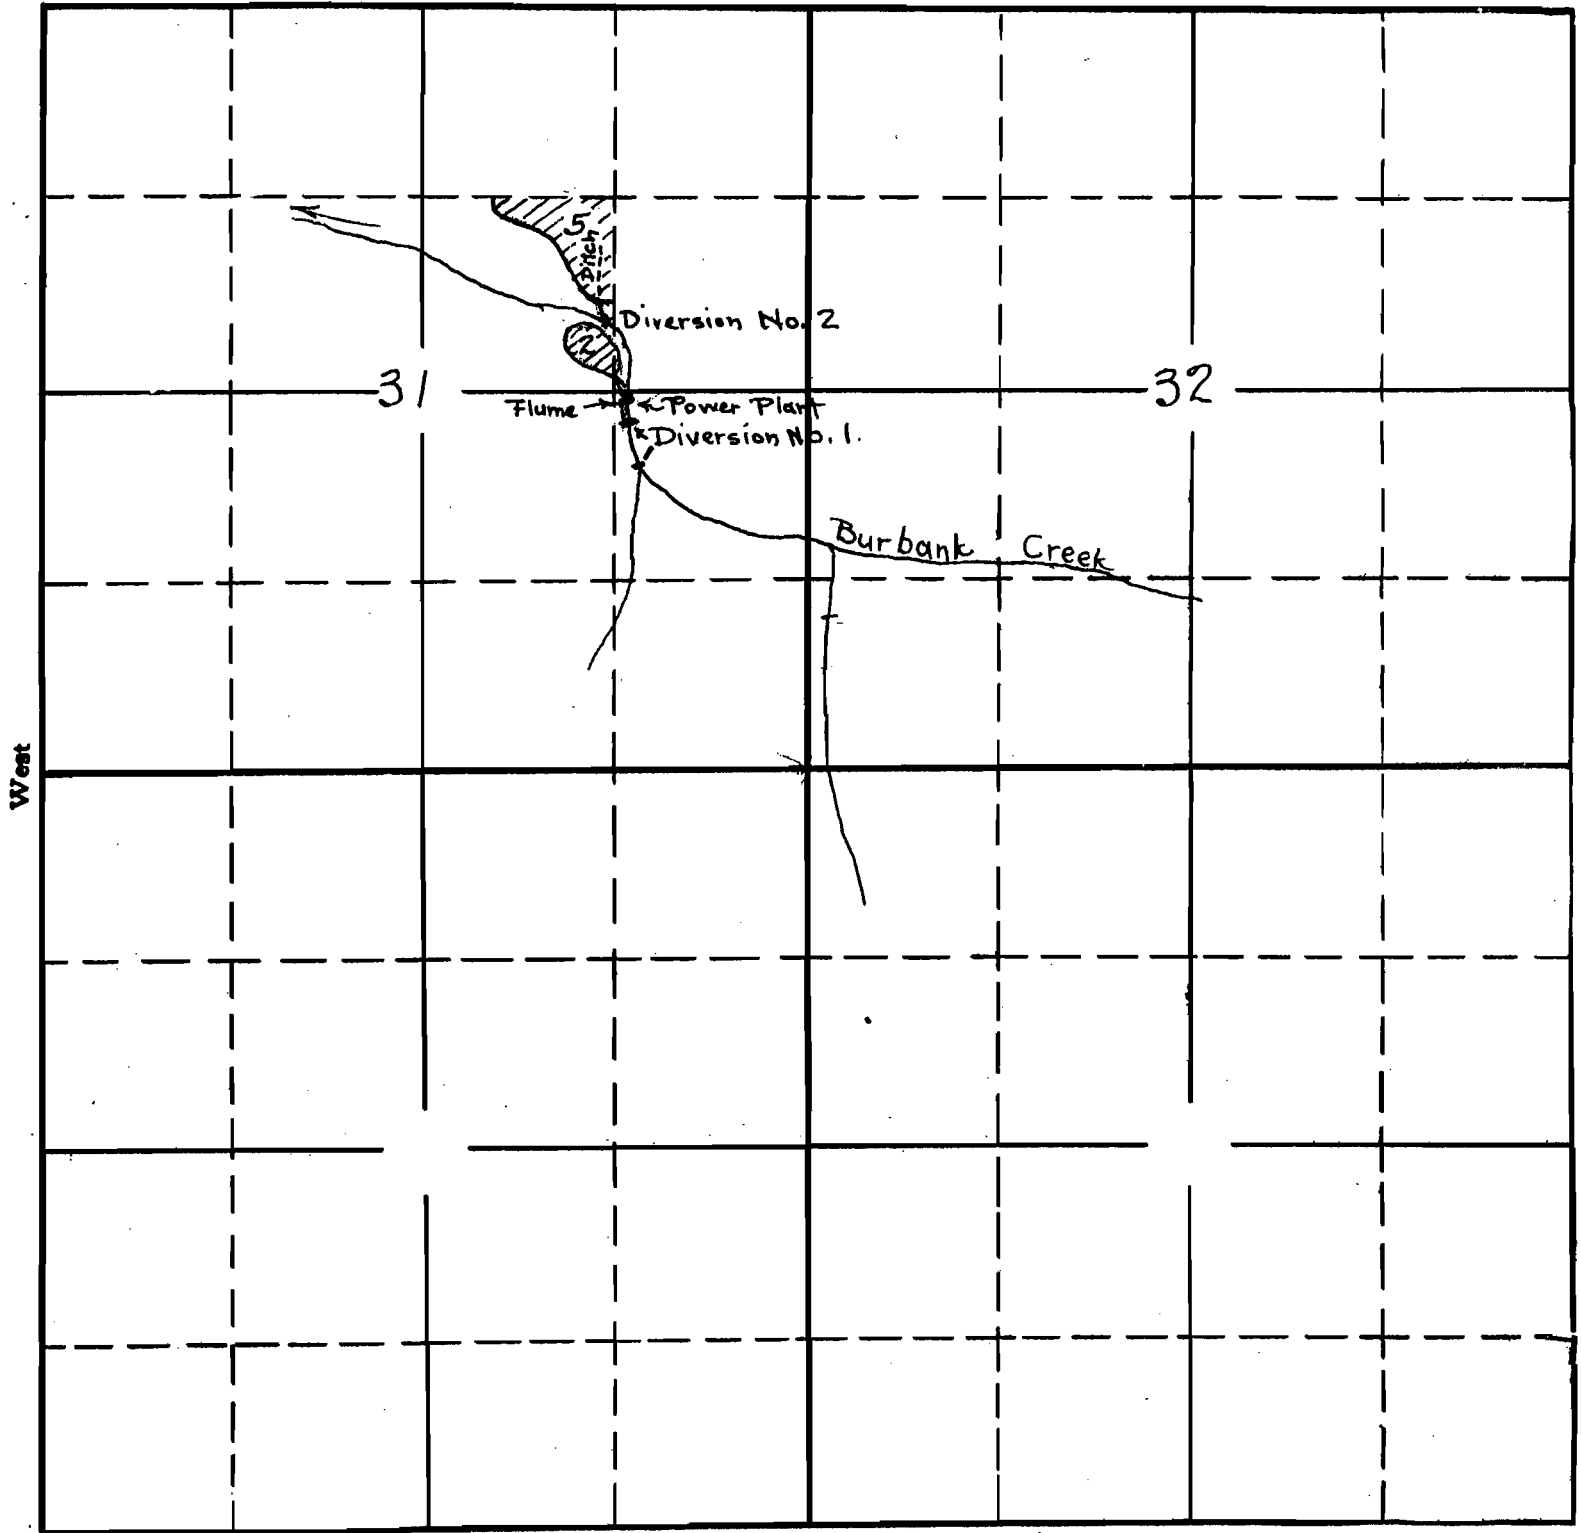

West

South

Amended map
to accompany permit,
Filed Dec. 8, 1930.

APPLICATION No. 11303
PERMIT No. 8013