


Application No. 64208
Permit No. 49052

Subdivided
6/6/05 LHN

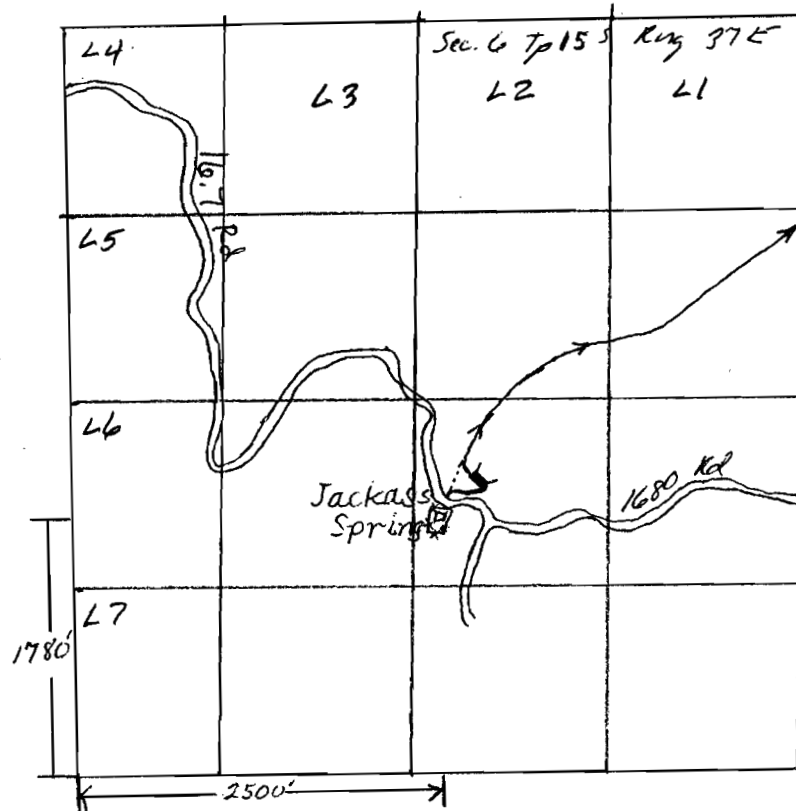

RECEIVED

SEP 29 1982

WATER RESOURCES DEPT.
SALEM, OREGON