


MAP D

69922

TUS TV
R251024

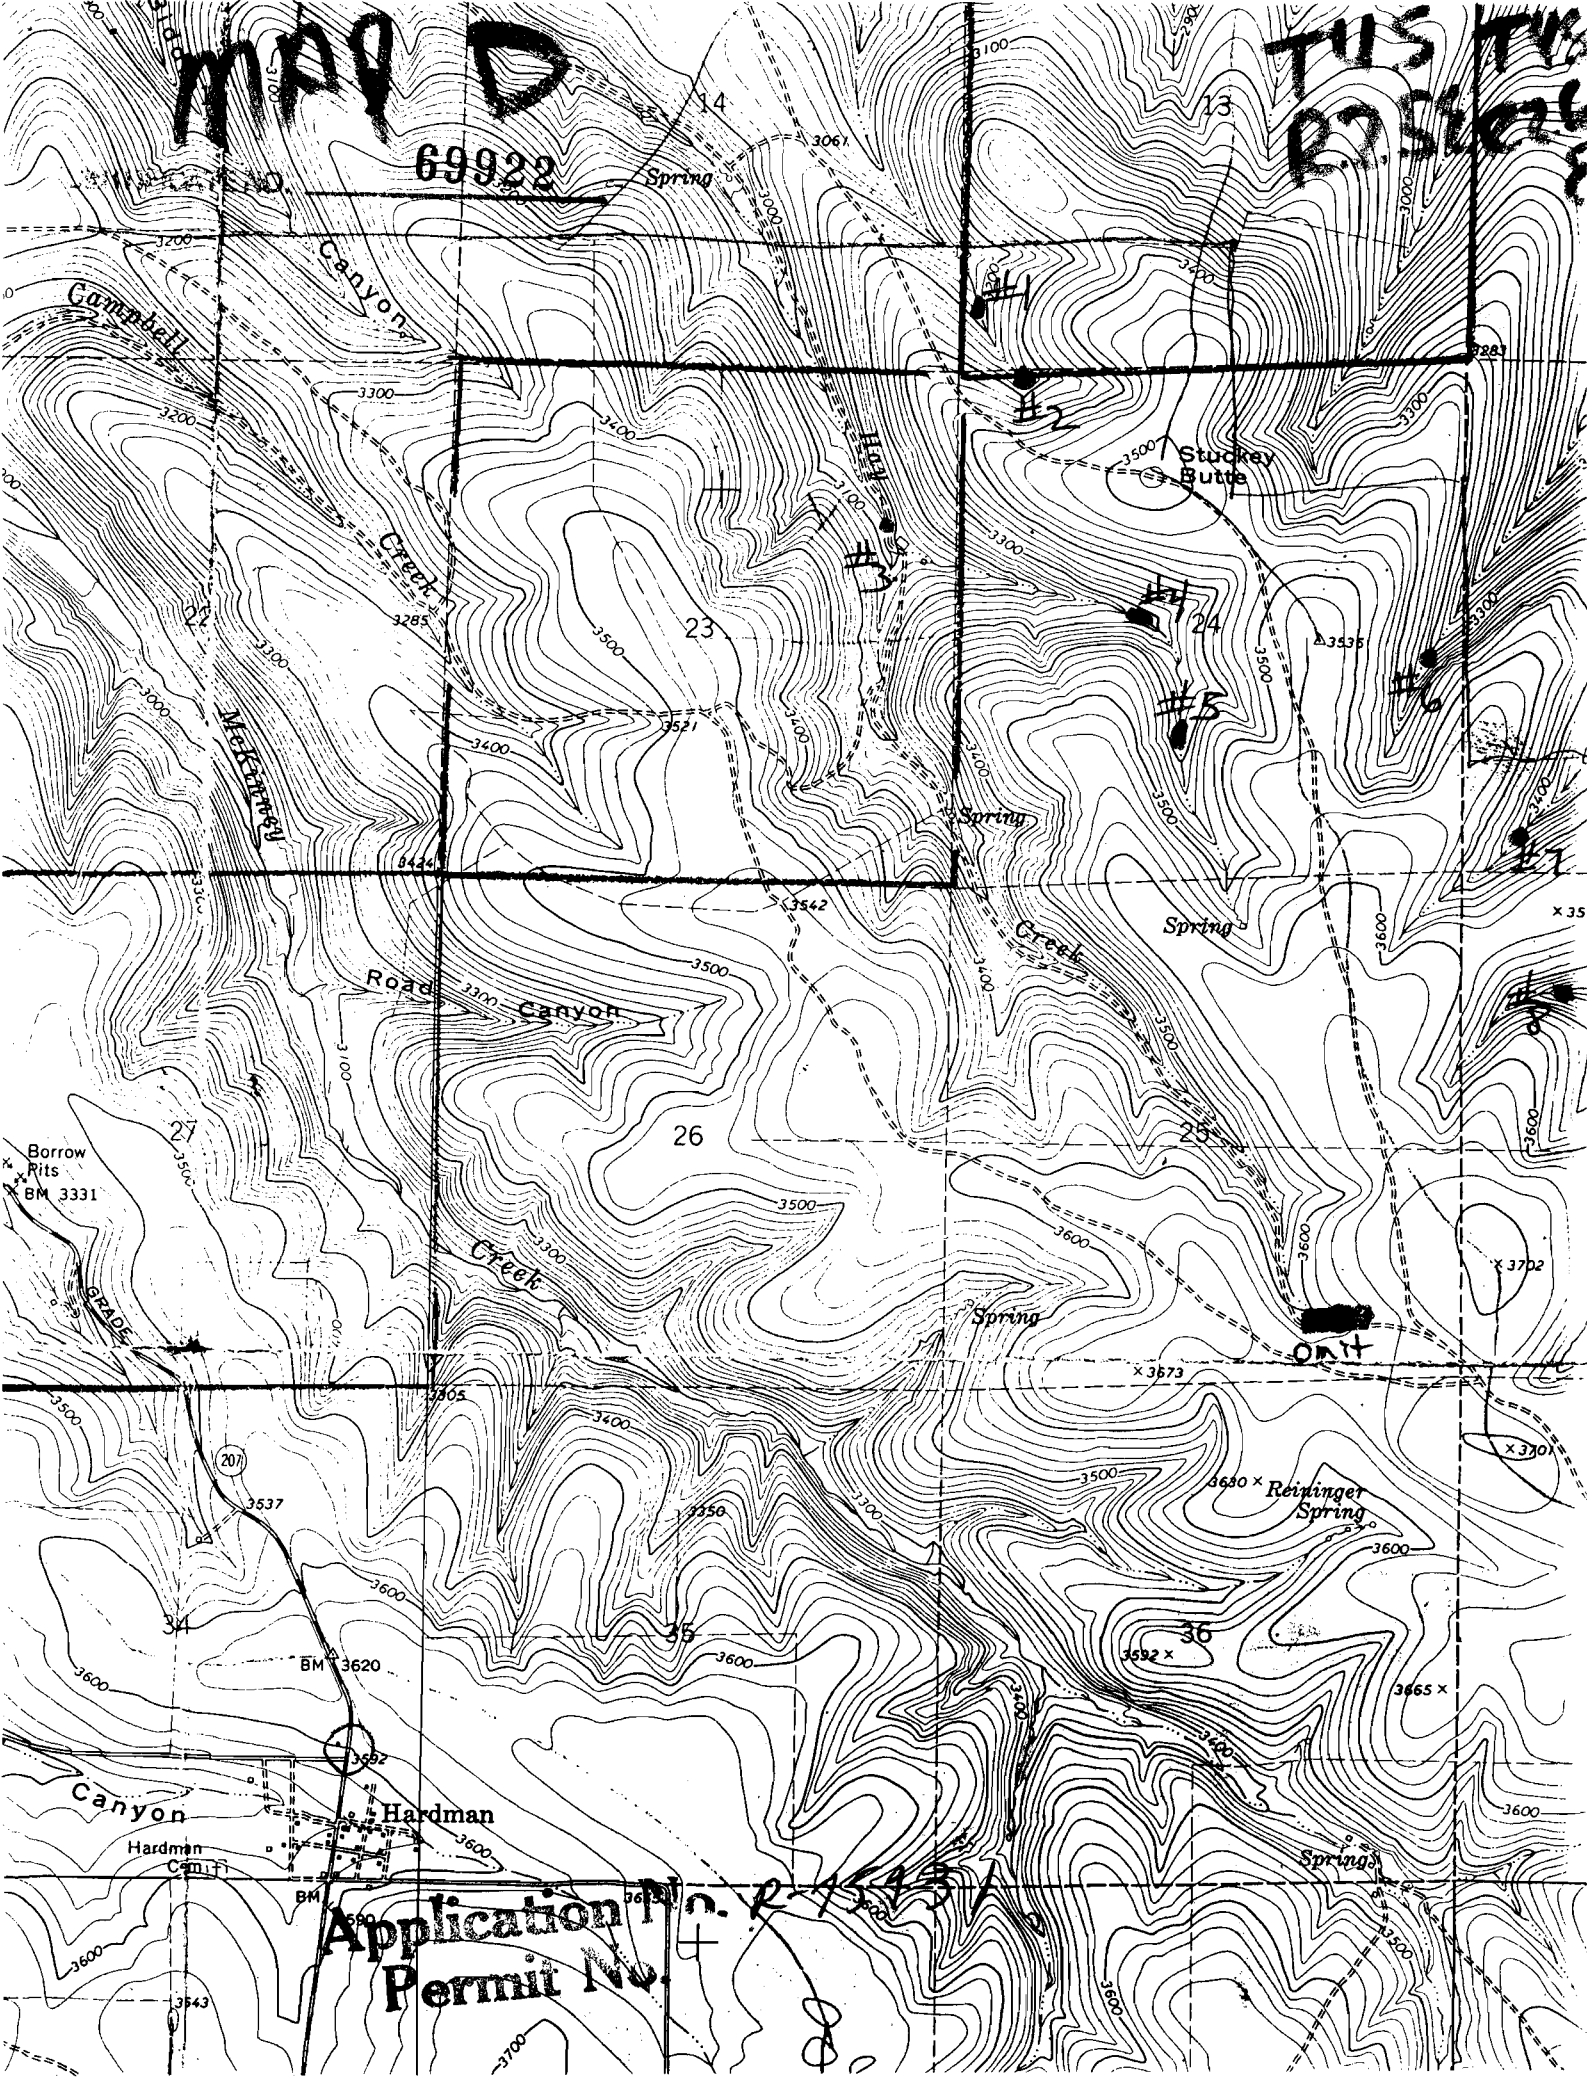

Application No. R-15451
Permit No.