


# T15S. R10E. W.M.

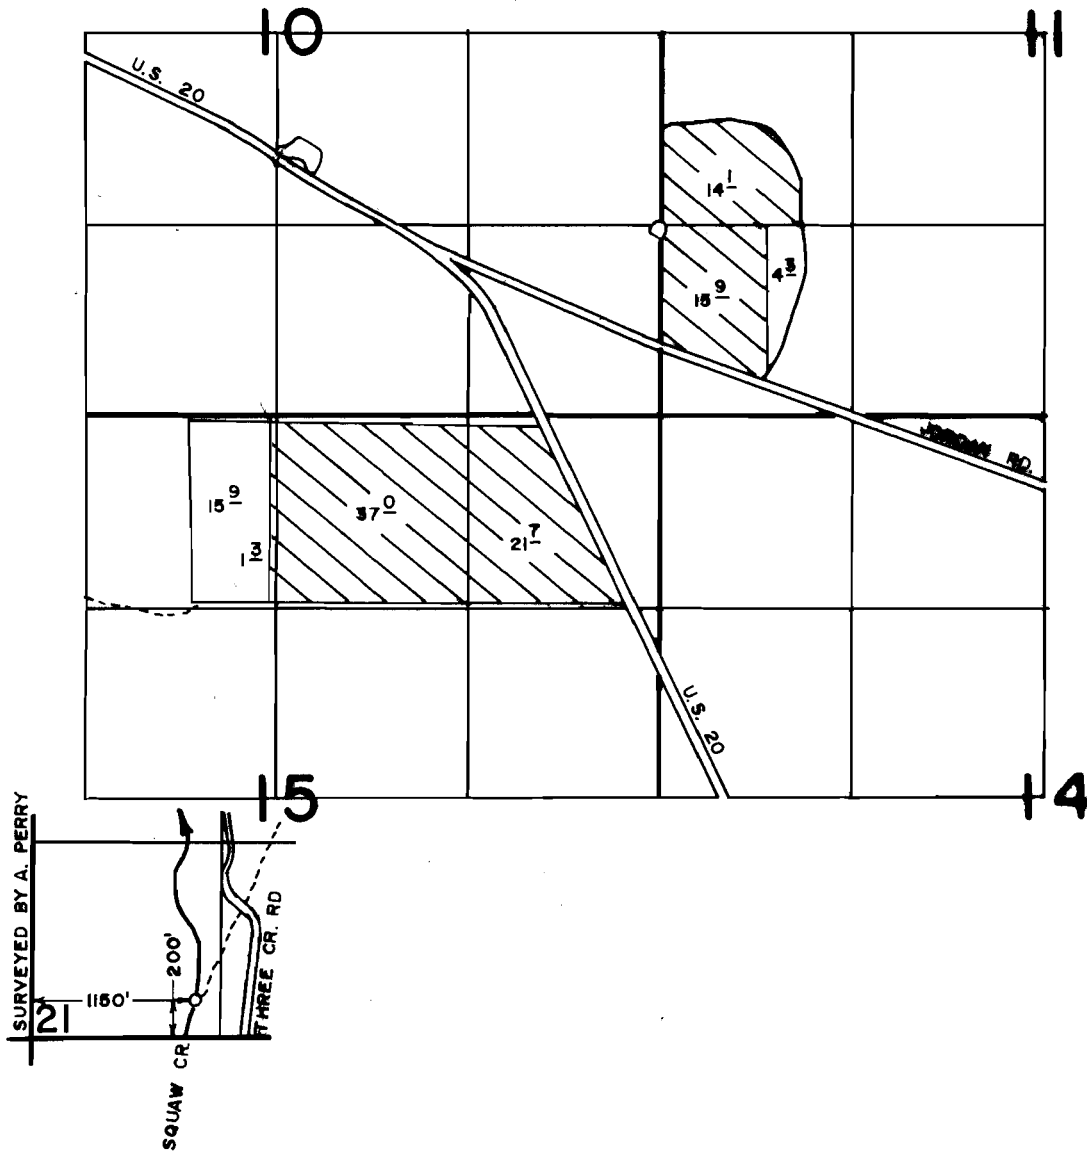

## FINAL PROOF SURVEY UNDER

TRANSFER NO. H-144

Application No. .... Permit No. ....  
IN NAME OF

.....**L.F. BROGAN**.....

Surveyed APR...24.. 1980., by L.H. NUNN.....