


T15S. R10E. W.M.

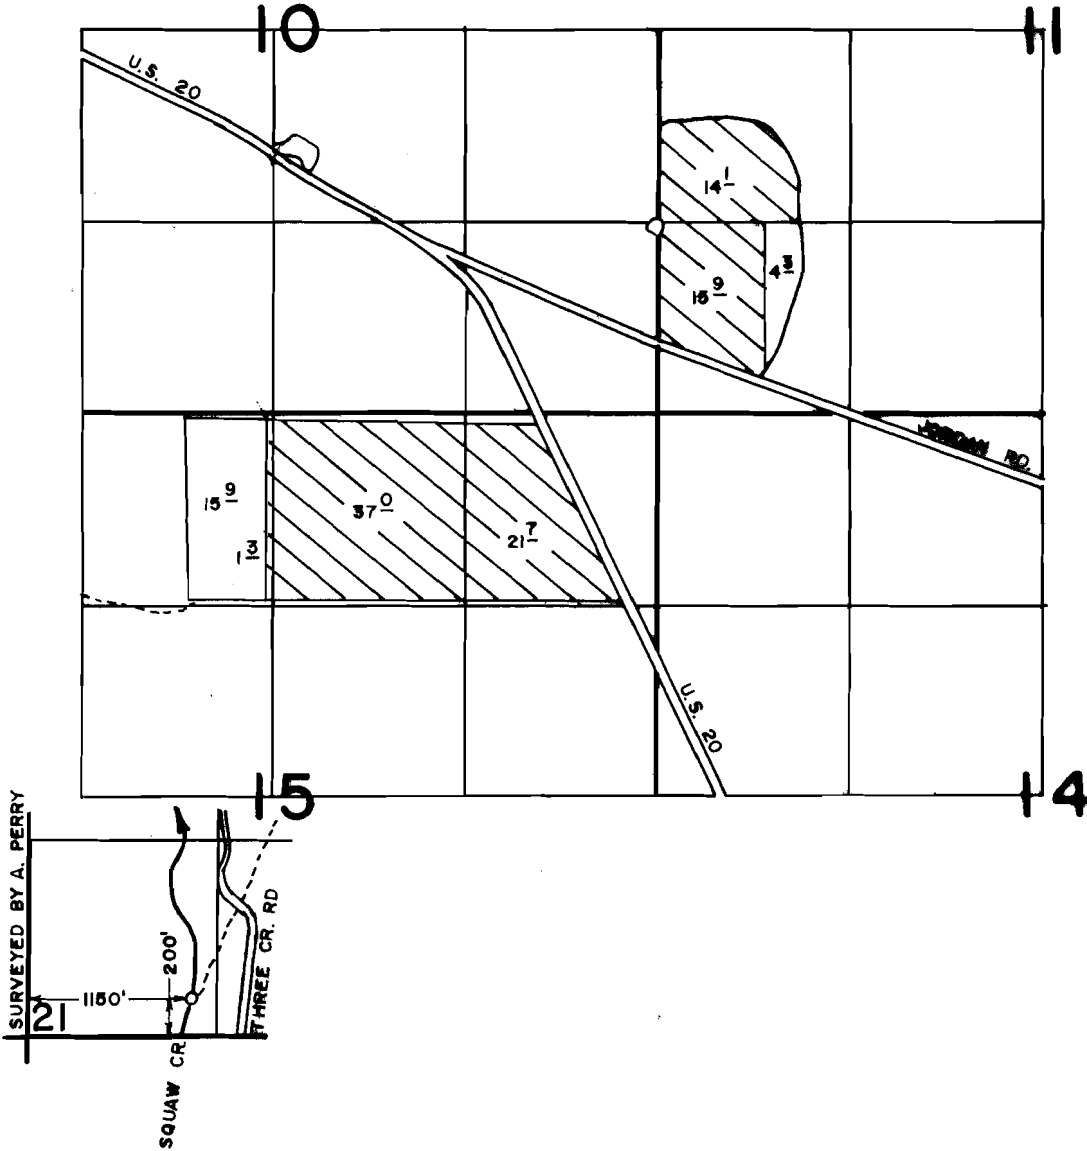

FINAL PROOF SURVEY UNDER

TRANSFER NO. H-144

Application No. Permit No.
IN NAME OF

..... **L.F. BROGAN**

Surveyed APR. 24. 1980., by L.H. NUNN.....