


# T. 1N. R. 3W. W.M.

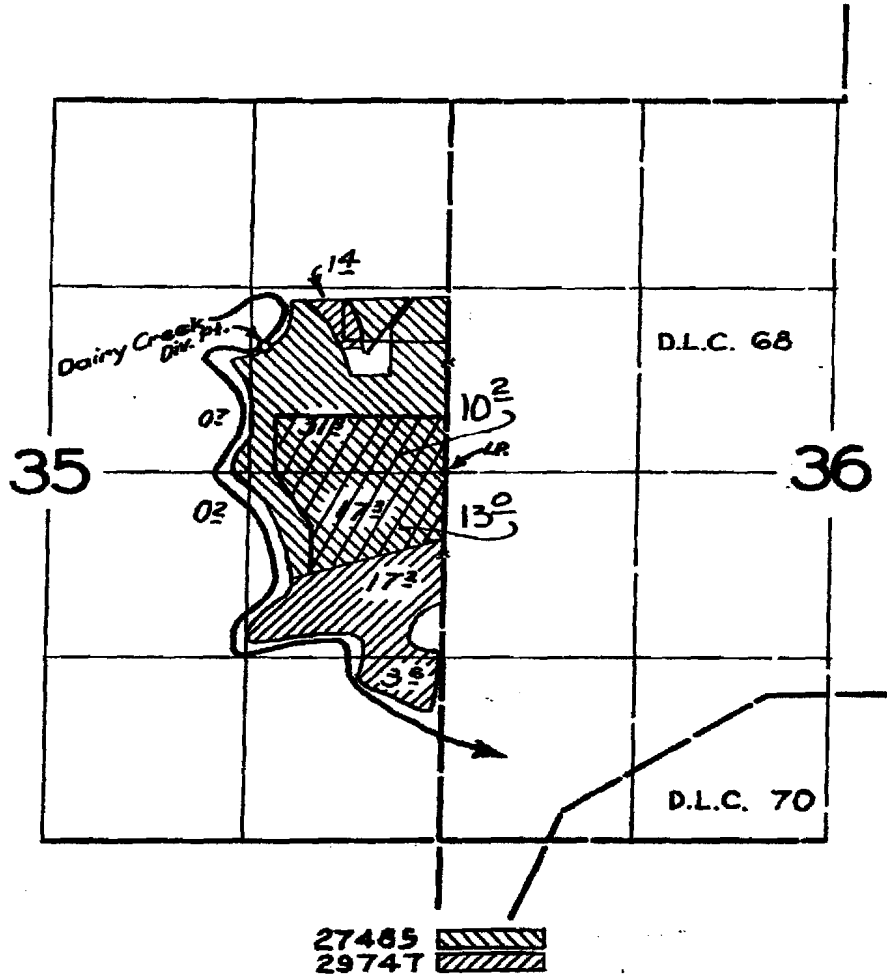

## FINAL PROOF SURVEY UNDER

Application No. ~~29747~~ <sup>27485</sup> Permit No. ~~23430~~ <sup>21634</sup>  
IN NAME OF

RAYMOND HERTEL

Surveyed 26 May 1959, by R. Jackson

RECEIVED

MAR 07 2005

WATER RESOURCES DEPT.  
SALEM, OREGON