


T. 1 N. R. 3 W. W. M.

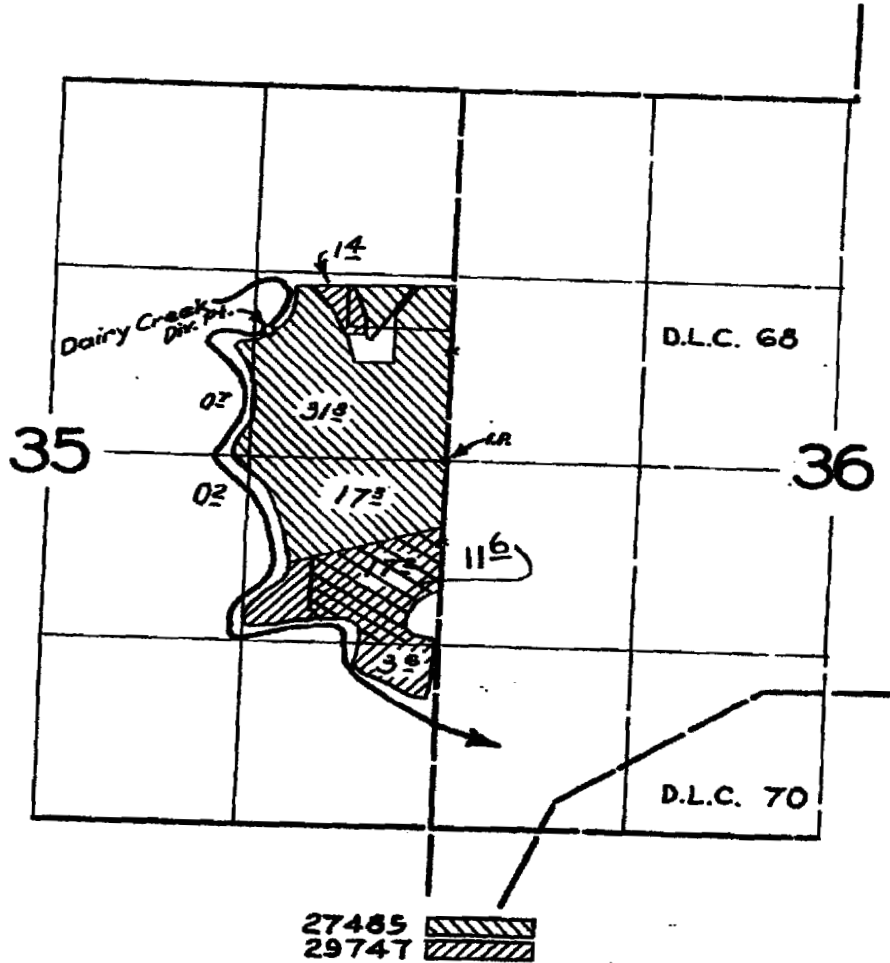

FINAL PROOF SURVEY
UNDER

Application No. 27485 Permit No. 21634
29747 25430
IN NAME OF

RAYMOND HERTEL

Surveyed 26 May 1959 by R. Jackson

RECEIVED

MAR 07 2005

WATER RESOURCES DEPT
SALEM, OREGON