


FINAL PROOF SURVEY MAP
T 8 S R 4 W, W.M.
 Prepared for Dave Setniker under file T-7784

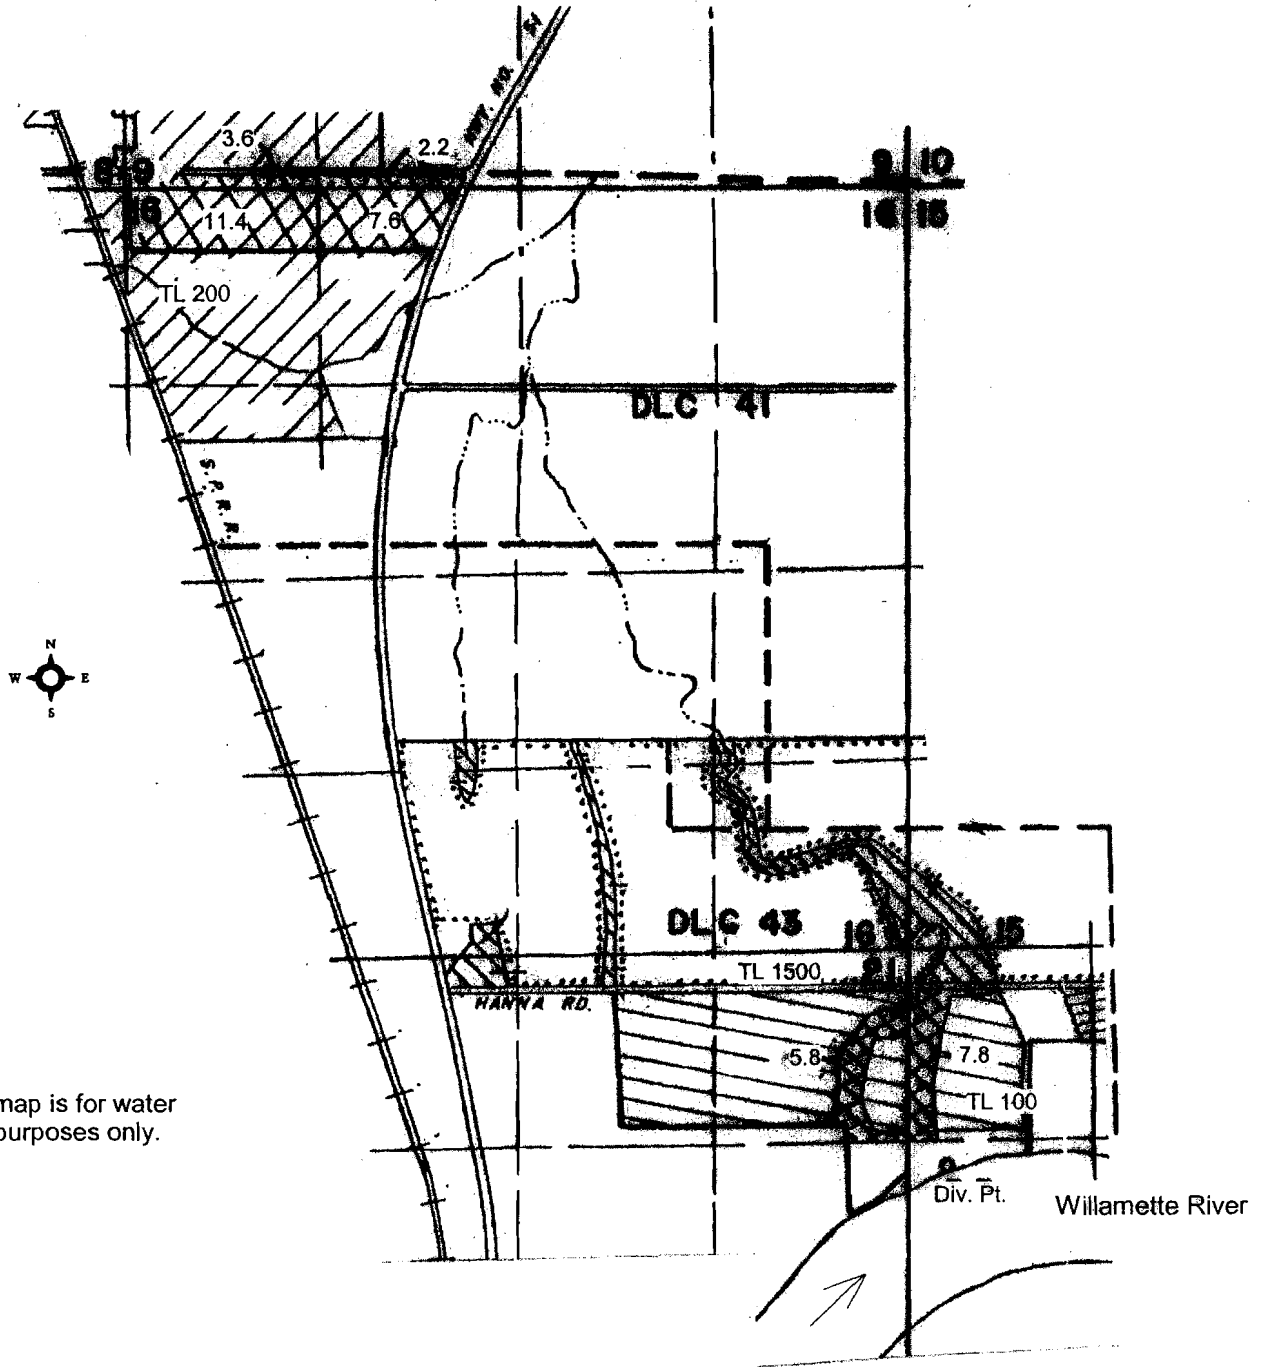

This map is for water right purposes only.

Div. Pt.: 2300' S & 1150' W of the easterly NE corner DLC 43

