





 
 

DAVE ROBERTSON  
 POINT OF DIVERSION TRANSFER  
 SW1/4 SW1/4 SEC32 &  
 SE1/4 SE1/4 SEC31, T5 N, R37 E W.M.

Id	Water_Righ	Location	Acres	Priority
3	Robertson Cert 13314	SW1/4SW1/4 Sec 32, T5 N, R37 E W.M.	3.8	1880
4	BPA/CTUIR Cert 13314	SW1/4SW1/4 Sec 32, T5 N, R37 E W.M.	3.3	1880
1	Hopper Cert 13314	SE1/4SE1/4 Sec 31, T5 N, R37 E W.M.	2.0	1880
2	Robertson Cert 13314	SE1/4SE1/4 Sec 31, T5 N, R37 E W.M.	4.3	1880

SF12 New Robertson POD Location  
 300ft N of SW corner of Sec32  
 N45.860903 W118.226978

SF11 Old Robertson POD Location  
 1100ft E & 600ft S of SW corner of Sec 32  
 N45.858581 W118.222278

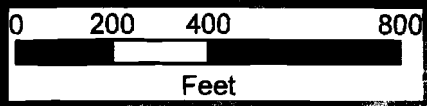
**Legend**

-  Section Corner Mark
-  D Robertson Property Tx Lt 6100
-  Qtr Sec Lines from Quads
-  GPSPODs
-  Cert 13314 Acreage Splits
-  Area Subject To Transfer
-  BPA CTUIR Property



NE1/4NW1/4  
 SEC 5  
 T4 N, R37 E W.M.

1 inch equals 400 feet



**RECEIVED**

SEP 24 2004

Certified Water Right 358

JOHN S. WARINNER  
 May 18, 1993

STATE OF OREGON

WATER RESOURCES DEPT  
 SALEM, OREGON

7.9794

Map for location purposes only  
 Boundaries and lines are approximate  
 Stephanie Eaton, OWRD  
 09/13/2004