



TOWNSHIP 18 SOUTH, RANGE 17 EAST, W.M.

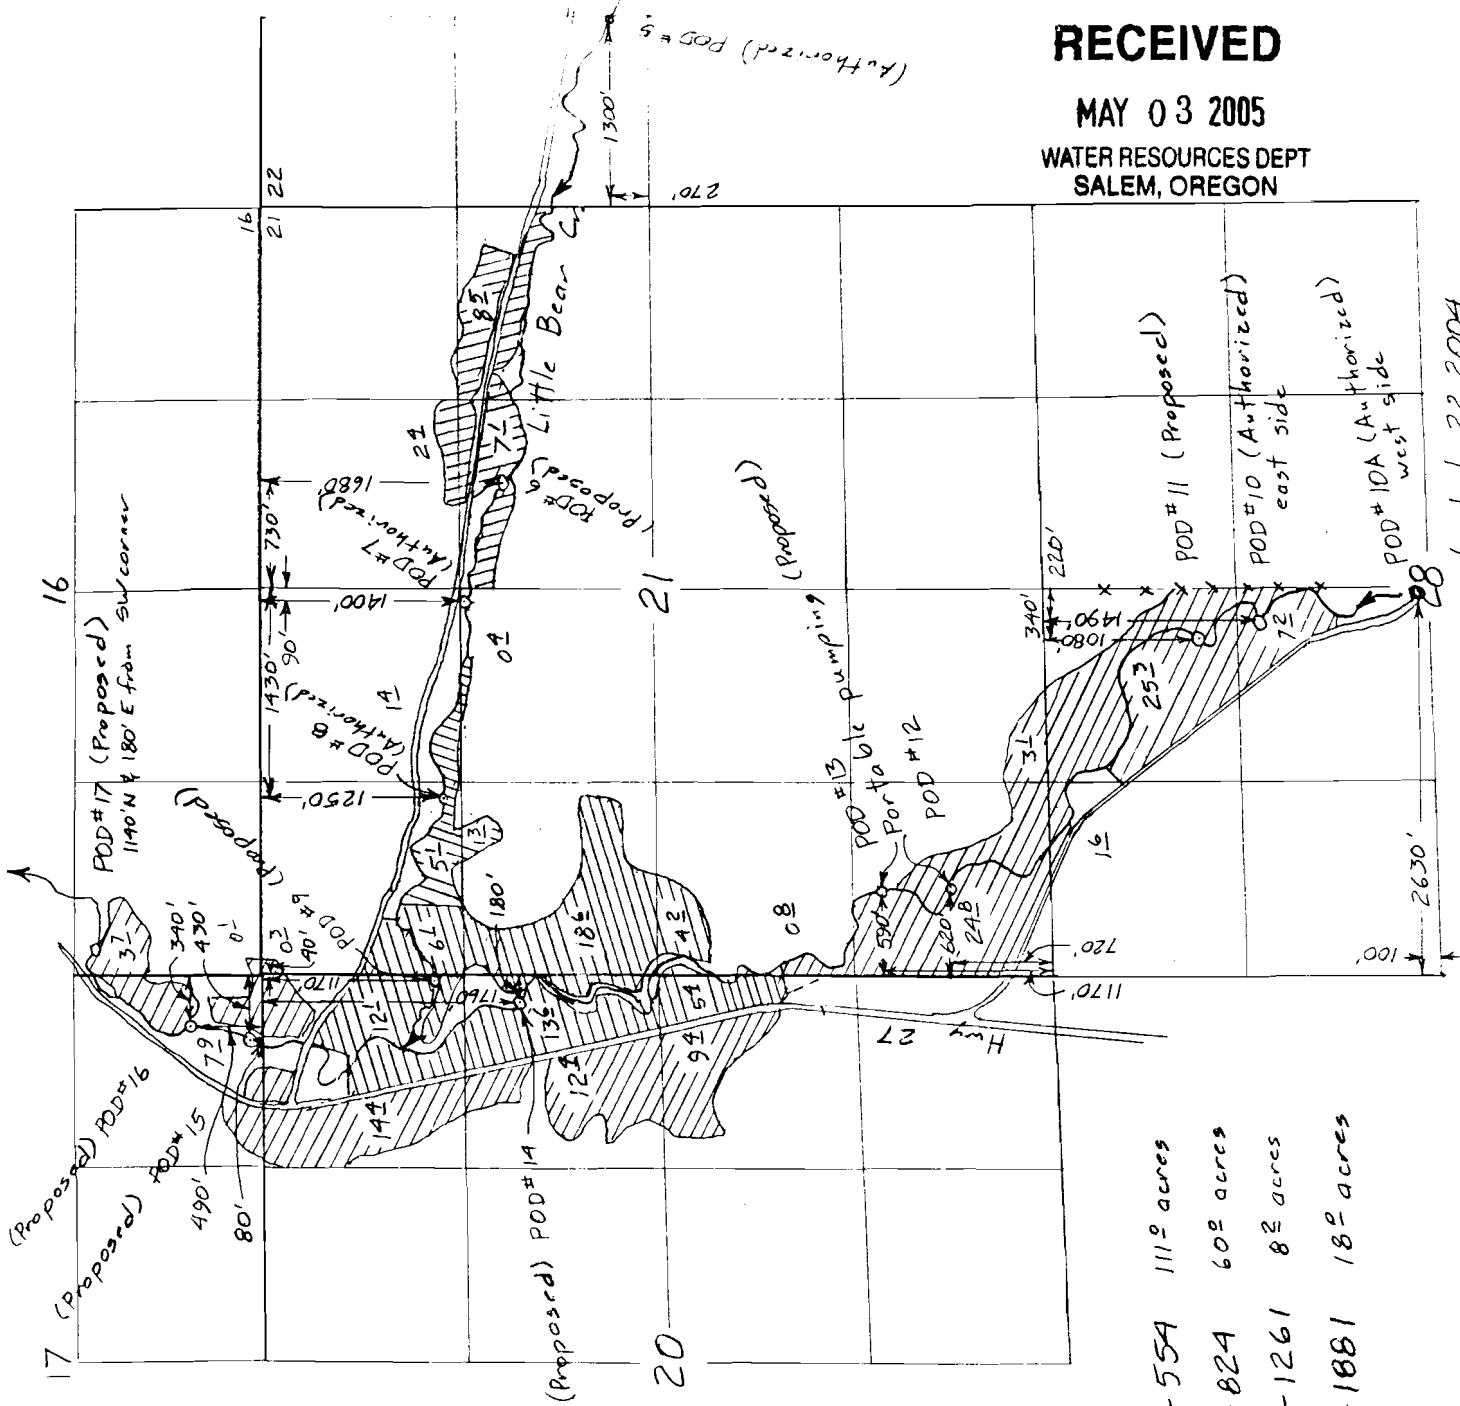

- ⊖ C-55A 111² acres
- ⊖ C-824 60² acres
- ⊖ C-1261 8² acres
- ⊖ C-1881 18² acres

RECEIVED
 MAY 03 2005
 WATER RESOURCES DEPT
 SALEM, OREGON

Surveyed July 22, 2004

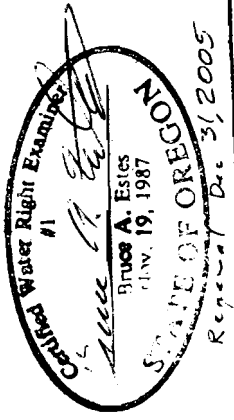

Claim of Beneficial Use Map
 for
 J.W. Hart, Sagehollow Ranch

ESTES SURVEYS, L.C.
 PO Box 17519, 60362 Arnold Rd
 Salem, OR 97306-7519 Bend, OR 97702
 (503) 585-7593 (541) 382-7391

This map is for the purpose of locating a water right only and has no intent to provide legal dimensions or the location of property lines.