


TOWNSHIP 18 SOUTH, RANGE 17 EAST, W.M.

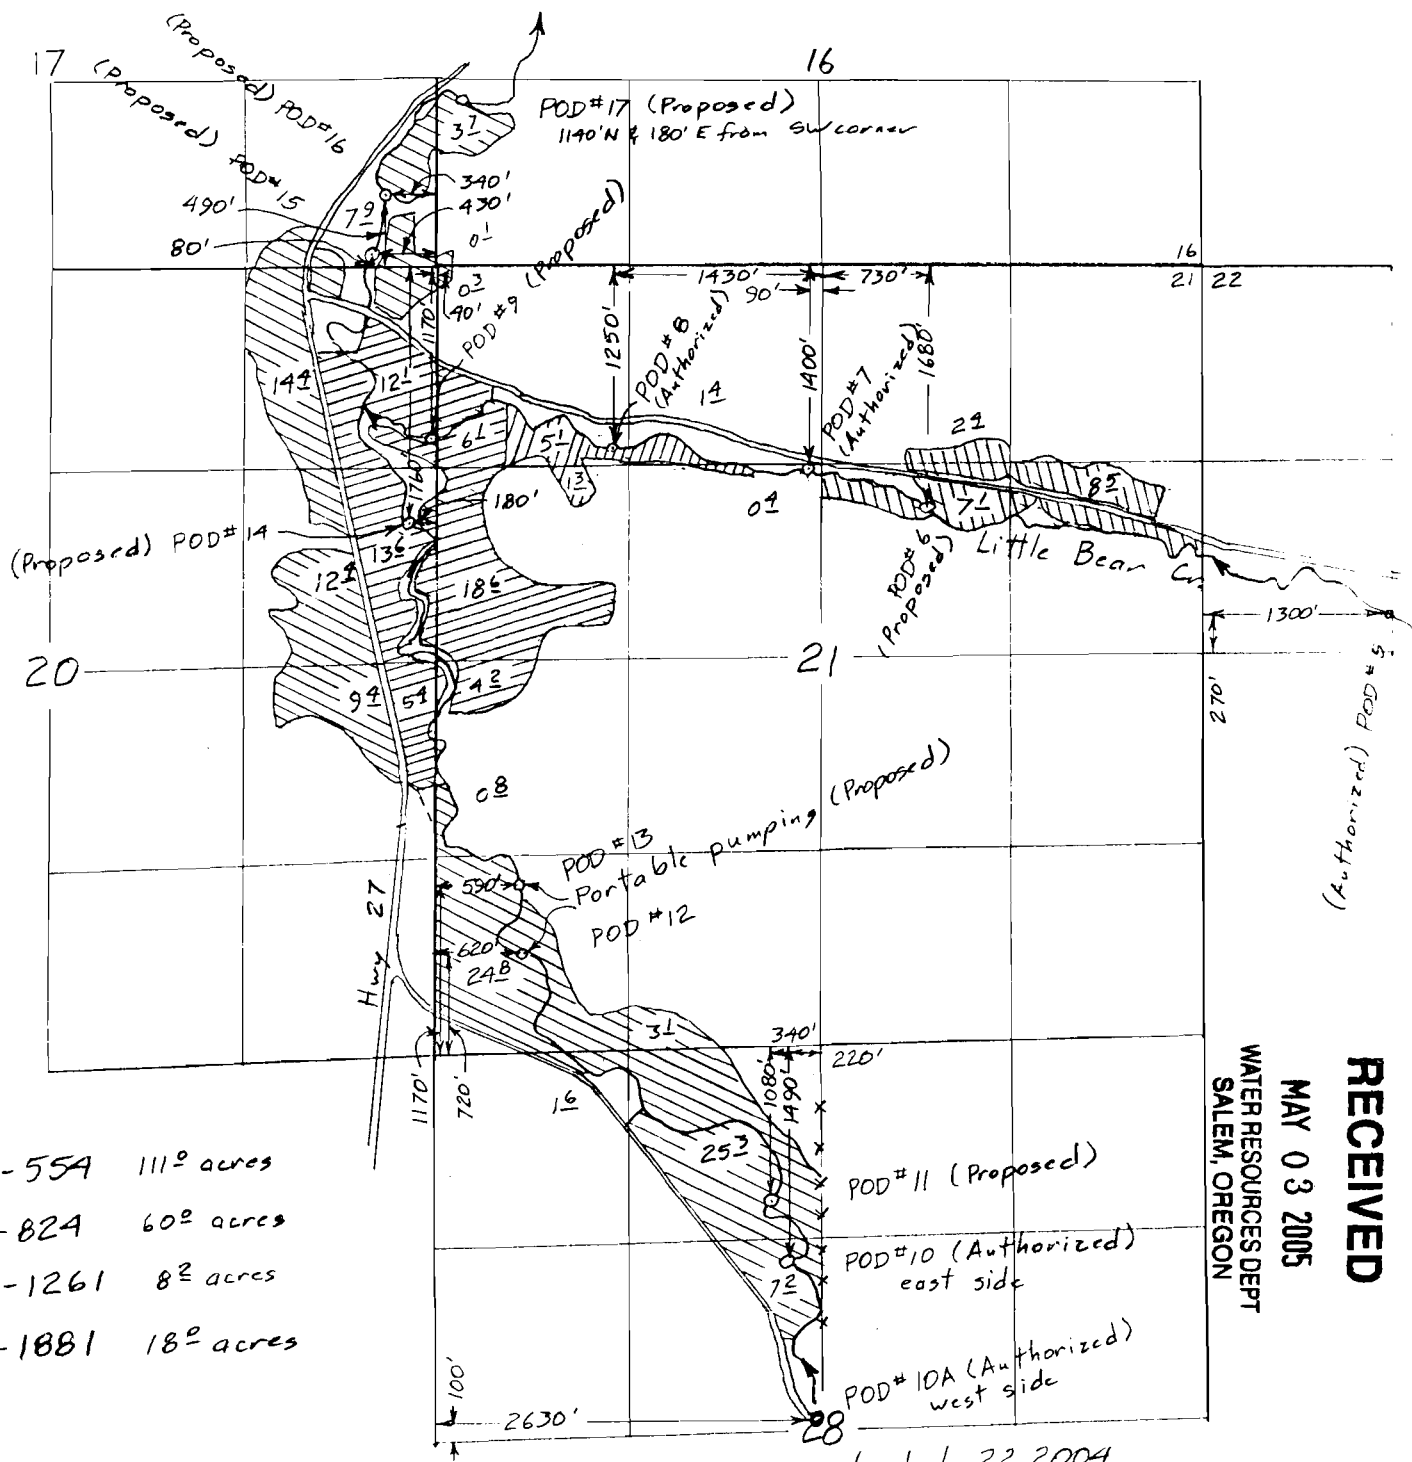


- ⊗ C-55A 111[±] acres
- ⊗ C-824 60[±] acres
- ⊗ C-1261 8[±] acres
- ⊗ C-1881 18[±] acres

Surveyed July 22, 2004

Claim of Beneficial Use Map
for
J.W. Hart, Sagehollow Ranch

This map is for the purpose of locating a water right only and has no intent to provide legal dimensions or the location of property lines.

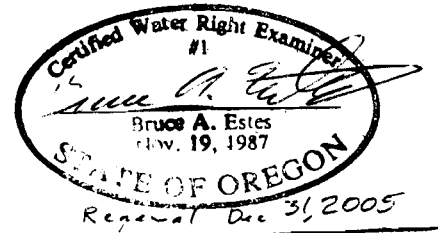

ESTES SURVEYS, LLC
 PO Box 17519 • 60382 Arnold Rd
 Salem, OR 97305-7519 • Bend, OR 97702
 (503) 585-7593 • (541) 382-7391

3Feb05 Sheet 1 of 2
Amended 11Apr05, 31May05

RECEIVED
 MAY 03 2005
 WATER RESOURCES DEPT
 SALEM, OREGON