TOWNSHIP 15 SOUTH, RANGE 10 EAST, W.M.

RR for C.81475

Scale
1" = 1320'
(4" = 1 mile)

N

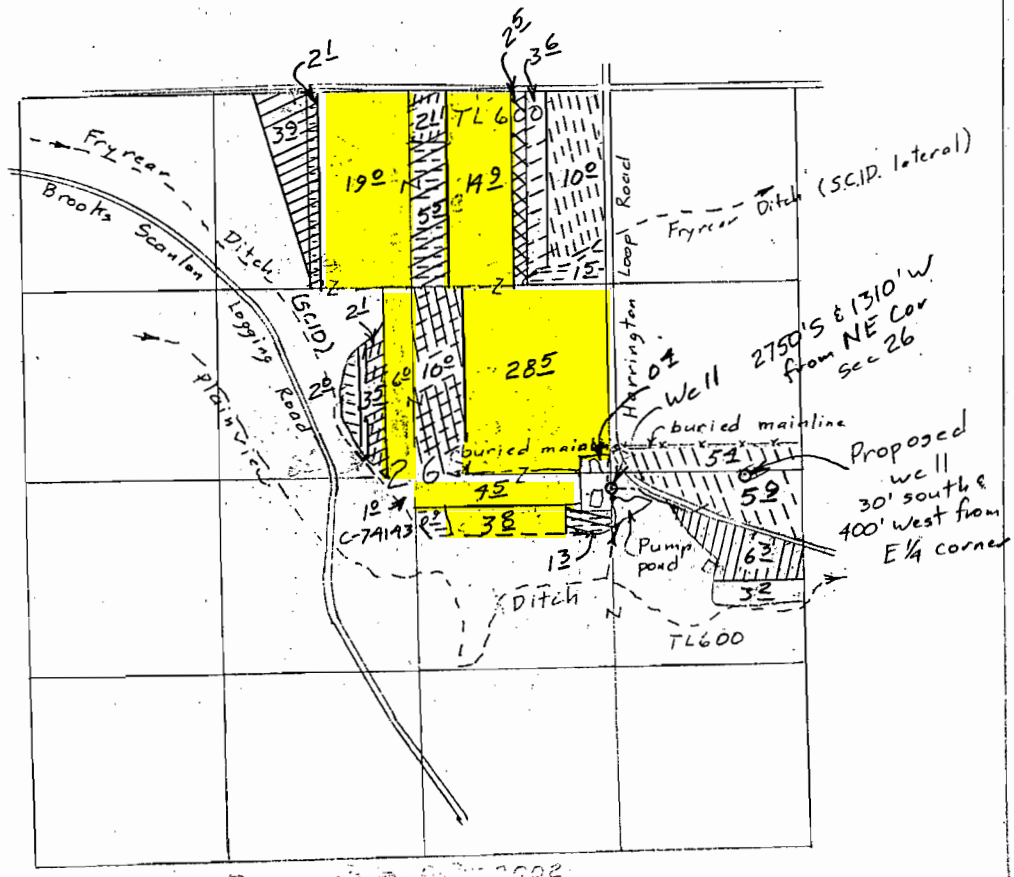

C-74143

From Primary 2° acres
To Primary 13 acres
From Supp (1904) 56 acres
To Supp (1904) 63 acres

C-74142

From Supp (1885) 10° acres
To Supp (1885) 10° acres
From Supp (1895) 136 acres
To Supp (1895) 136 acres
From Supp (1904) 113 acres
To Supp (1904) 0°
To Supp (1904) & Δ POA 113 acres

Cancel Supp (1895) 25 acres

Transfer Application Map
for
Weldon Wankier
(Black Diamond Ranch)

T-9571

AUG 0 1 2005

Certified Water Right Examiner #1
Bruce A. Estes
Bruce A. Estes
Nov. 19, 1987
STATE OF OREGON
Renewal Dec 31, 2003

Sheet 2 of 2

This map is for the purpose of locating a water right only and has no intent to provide legal dimensions or the location of property lines.

ESTES SURVEYS, LLC
PO Box 17519
Salem, OR 97305-7519
(503) 585-7593
60382 Arnold Rd
Bend, OR 97702
(541) 382-7391

Amended 3/8/05 7/20/05 4/5/05