
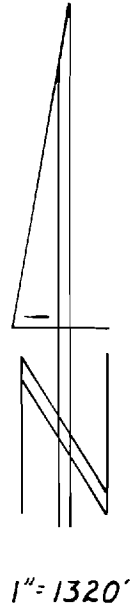


T. 6 S., R. 4 W., W.M.

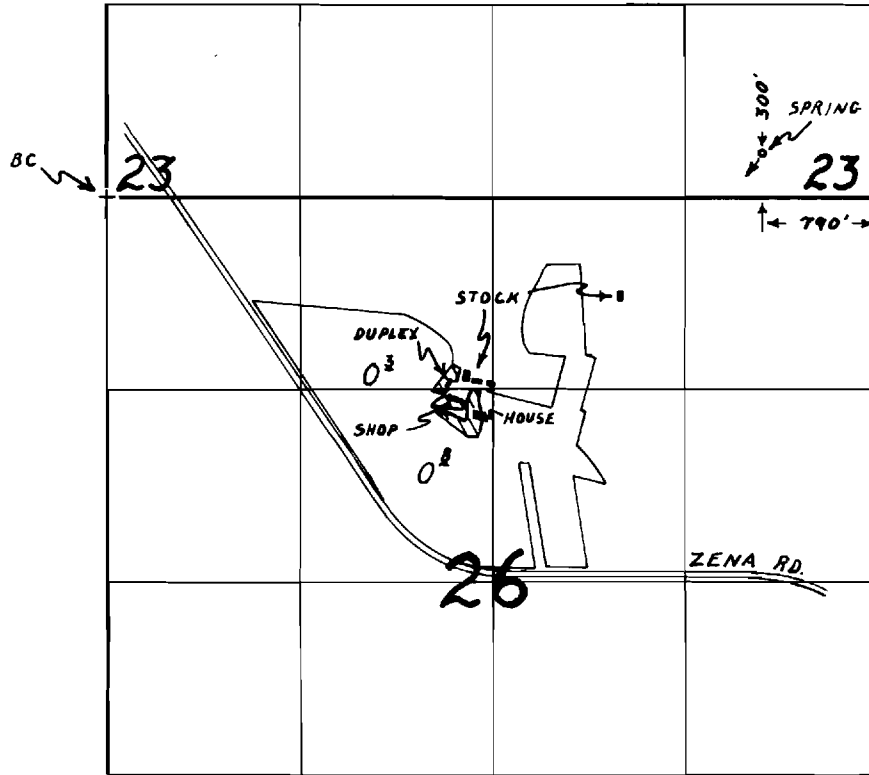

FINAL PROOF SURVEY

UNDER

Application No. 63520 Permit No. 47077
IN NAME OF

Raymond Manning O'Connor

Surveyed July 1, 1993, by R.W. Klassen