



SE 1/4 SECTION 13, T29S, R5W, WM

13

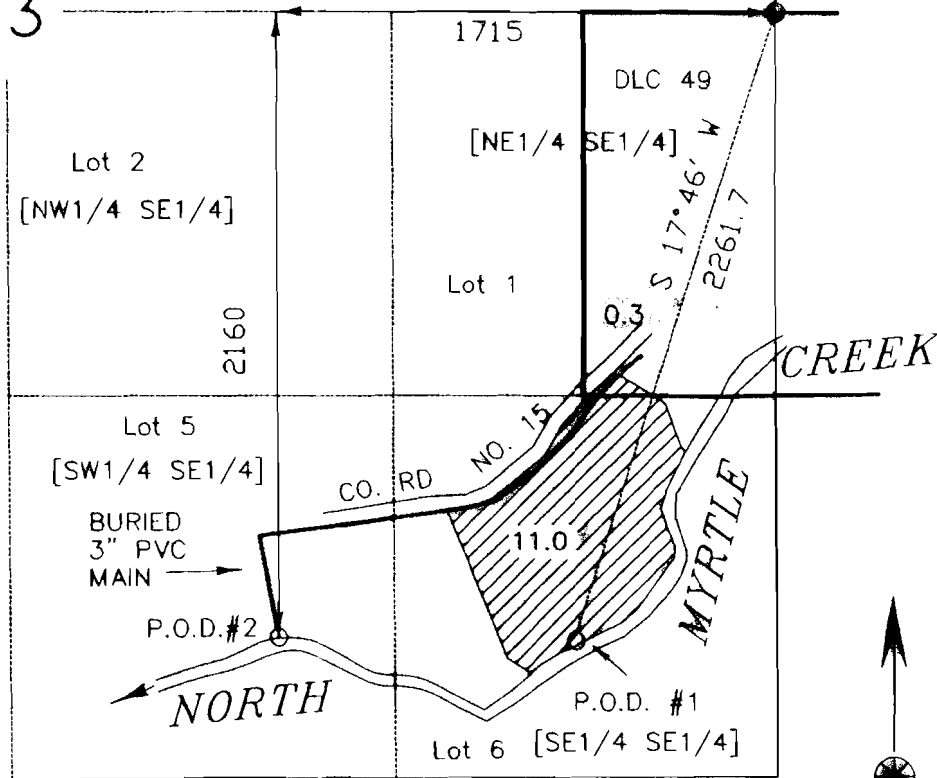

SCALE 8" = 1 MILE

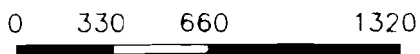

SCALE

SURVEY BASED ON
SURVEY FOR PERMIT
24813 FOR E.V. WEAVER




THIS MAP IS TO BE USED FOR WATER RIGHT PURPOSES ONLY

ASSESSOR PAGE 29 05 13
TAX LOT 200

MAP TO ACCOMPANY CLAIM OF BENEFICIAL USE FOR WATER RIGHT TRANSFER T-8055

IN NAME OF

Stanley E. and Margo L. Tenold

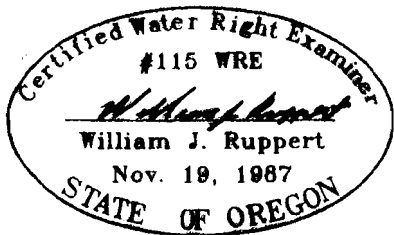

BY:
WILLIAM J. RUPPERT
P.O. BOX 1564
MYRTLE CREEK, OR 97457

RECEIVED

JAN 28 2005

NOV. 21, 2004

WATER RESOURCES DEPT
SALEM, OREGON